

MAR 09 1993

COMMISSION

Chippewa County Remonumentation Corner

RECEIVED FOR RECORD
CHIPPEWA COUNTY
STATE OF MICHIGAN

LAND CORNER RECORDATION CERTIFICATE 93 DEC 29 AM 10:27
Filing Requirement of Act 74, Mich. P.A. 1970

For corners in

Chippewa
(County)


Located In:

Corner Code ##

J. Roger Malachuk
REGISTER OF DEEDS

- 1. Public Land Survey T 45N R 1E I-9
- 2. Property Controlling in Section S ___ T ___ R ___
- 3. Miscellaneous Property in Sec. S ___ T ___ R ___
- 4. Lot No. _____, Recorded Plat _____
- 5. Private Claims _____

Register of Deeds Stamp & File Number

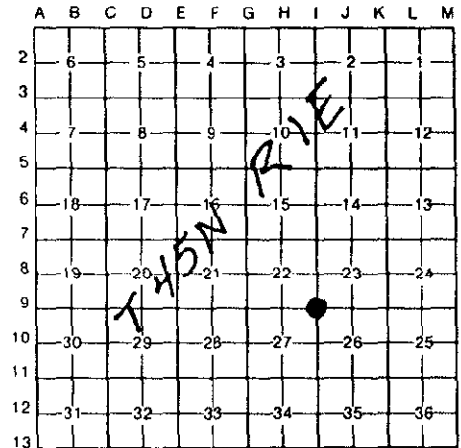

I, Larry R. Rogers, in a field survey on November 12, 19 93

do hereby certify that under requirements of P.A. 74, Michigan P.A. of 1970, the corner points mentioned in lines 1 and 2 above were in conformance with regulations and rules therefore as required in the current manual of survey instructions of the United States Department of the Interior, Bureau of Land Management or by a decree of a Court of Law and/or that the corner points mentioned in lines 3, 4 and 5 above were in conformance with the rules of the Michigan Board of Land Surveyors or by a Decree of a Court of Law; established, re-established, monumented, re-monumented, recovered, found as expressed below:

NOTE: Not more than 4 corners, all in the same town and range, may be recorded on this certificate.

A. Description of original monument and accessories and/or subsequent restoration:

(I-9) Section Corner Common to Sections 22, 23, 26 & 27, T45N-R1E


Corner position was reestablished in 1984 by D.B. Babbitt (M.D.N.R.) from Maple stump referred to in 1925 County Surveyor notes, and recorded in Liber 6, Page 164 of the Chippewa County Corner Records as a 1" iron pipe with the following witnesses:

- 16" Maple stump N29°W 130.50'
- 5" Spruce S88°W 69.05'
- Tag in Power Pole N57°E 55.35'
- 14" Aspen S50°W 96.90'
- Tag in Power Pole N40°W 57.25'

B. Description of corner evidence found and/or method applied in restoring or reestablishing corner:

(I-9) This corner is being perpetuated as part of the Chippewa County Remonumentation Program.

Found 1" pipe with P.S. cap #21588 in centerline of Riverside Drive and recovered three witnesses from 1984 record. Accepted corner position as found and established one new witness.

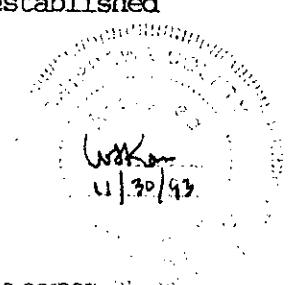

C. Description of monument for corner and accessories established to perpetuate locating the position of the corner:

(I-9) Corner is a 1" iron pipe with P.S. cap #21588 in centerline of Riverside Drive and Sixteen Mile Road to the East.

- Witnesses: Utility Pole N51°E 55.37'
- Utility Pole N43°W 57.25'
- 6" Spruce S86°W 69.30'
- Wood Sign Post S51°E 71.64'



Signed by *[Signature]*
Surveyor's Michigan License No. 29251

Date 30 NOV 1993

NOTE: Bearings are compass bearings corrected for declination.
Distances are to a nail in side of witness objects unless noted.