

MAR 09 1994

Chippewa County Remonumentation Corner

RECEIVED FOR RECORD
CHIPPEWA COUNTY
STATE OF MICHIGAN

COMMISSION

LAND CORNER RECORDATION CERTIFICATE
Filing Requirement of Act 74, Mich. P.A. 1970

93 DEC 29 AM 10:27

For corners in

Chippewa (County)	Located In:	Corner Code #
1. Public Land Survey	T <u>45N</u> R <u>1E</u>	<u>I-12</u>
	T _____ R _____	_____
	T _____ R _____	_____
	T _____ R _____	_____
2. Property Controlling in Section	S _____ T _____ R _____	_____
	S _____ T _____ R _____	_____
3. Miscellaneous Property in Sec.	S _____ T _____ R _____	_____
	S _____ T _____ R _____	_____

J. Roger Maltbie

REGISTER OF DEEDS

Register of Deeds Stamp & File Number

4. Lot No. _____, Recorded Plat _____
5. Private Claims _____

I, Larry R. Rogers, in a field survey on November 11, 1993
do hereby certify that under requirements of P.A. 74, Michigan P.A. of 1970, the corner points mentioned in lines 1 and 2 above were in conformance with regulations and rules therefore as required in the current manual of survey instructions of the United States Department of the Interior, Bureau of Land Management or by a decree of a Court of Law and/or that the corner points mentioned in lines 3, 4 and 5 above were in conformance with the rules of the Michigan Board of Land Surveyors or by a Decree of a Court of Law; established, re-established, monumented, re-monumented, recovered, found as expressed below:

	A	B	C	D	E	F	G	H	I	J	K	L	M
2	6		5		4		3		2		1		
3													
4	7		8		9		10		11		12		
5													
6	18		17		16		15		14		13		
7													
8	19		20		21		22		23		24		
9													
10	30		29		28		27		26		25		
11													
12	31		32		33		34		35		36		
13													

NOTE: Not more than 4 corners, all in the same town and range, may be recorded on this certificate.

A. Description of original monument and accessories and/or subsequent restoration:
(I-12) 1/4 Corner Common to Sections 34 and 35, T45N-R1E


This corner was previously recorded in 1984 by D.B. Babbitt in Liber 6, Page 165 of the Chippewa County Corner Records as a 1" iron pipe, 2.3' West of centerline of Riverside Drive, with the following witnesses:

Fence Post	N57°W	55.45'
8" Tamarack	S73°E	64.80'
6" Twin Cedar	S51°E	70.60'
10" Tamarack	S31°E	88.70'

B. Description of corner evidence found and/or method applied in restoring or reestablishing corner:

(I-12) This corner is being perpetuated as part of the Chippewa County Remonumentation Program.


Found 1" iron pipe 2.6' West of the centerline of Riverside Drive, 2.5' South of extension of fence line to the East. Corner position checks with three remaining witnesses from 1984 record. Placed plastic remonumentation cap on pipe and established two new witnesses.

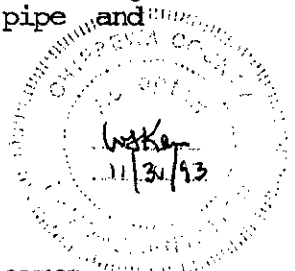

C. Description of monument for corner and accessories established to perpetuate locating the position of the corner:

(I-12) Corner is a 1" iron pipe with plastic remonumentation cap, 2.6' West of centerline of Riverside Drive.

Witnesses: Fence Post	N60°W	55.45'
Utility Pole (DR2/190A/27)	S30°W	109.69'
10" Tamarack	S38°E	89.38'
Twin 6" Cedar	S55°E	71.12'
Utility Pole	N86°E	44.68'

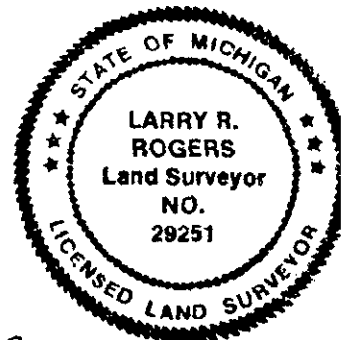

Signed by [Signature] Date 14 DEC 1993

Surveyor's Michigan License No. 29251

NOTE: Bearings are compass bearings corrected for declination.
Distances are to a nail in side of witness objects unless noted.