

MAR 09 1994 CHIPPEWA COUNTY REMONUMENTATION CORNER

COMMISSION

LAND CORNER RECORDATION CERTIFICATE

Filing Requirement of Act 74, Mich. P.A. 1970

RECEIVED FOR RECORD
CHIPPEWA COUNTY
STATE OF MICHIGAN

93 DEC 30 PM 2:46

J. Roger Matthe
REGISTER OF DEEDS

Register of Deeds Stamp & File Number

For corners in
Chippewa

(County)

Located In:

Corner Code #

T 45N R 1E K-7

T R

T R


T R

S T

S T

S T

S T

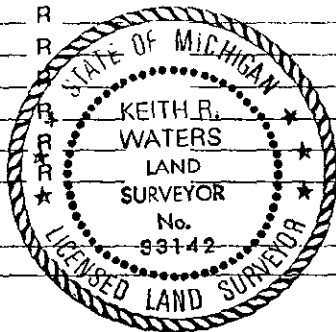

Lot No. _____, Recorded Plat _____

Private Claims _____

Keith R. Waters November 24 93

in a field survey on _____, 19 _____

I hereby certify that under requirements of P.A. 74, Michigan P.A. of 1970, the corner points mentioned in lines 1 and 2 above were in conformance with regulations and rules therefore as required in the current manual of survey instructions of the United States Department of the Interior, Bureau of Land Management or by a decree of a Court of Law and/or that the corner points mentioned in lines 3, 4 and 5 above were in conformance with the rules of the Michigan Board of Land Surveyors or by a Decree of a Court of Law; established, re-established, monumented, re-monumented, recovered, found as expressed below:

NOTE: Not more than 4 corners, all in the same town and range, may be recorded on this certificate.

Description of original monument and accessories and/or subsequent restoration:

K-7 Corner Common to Sections 13, 14, 23, & 24, T45N, R1E

Original ties to post: Birch 24, S50°W 42 links Fir 10, N16°E 40 links

This corner is recorded in liber 6, page 90, of Chippewa County corner records by William L. Karr, P.S. 27450 (1984), as a 1 1/2" pipe 1.3 feet south of centerline of road with the following ties: 8" Red Pine, S55°E 83.90' 14" Maple, N44°E 93.12' Power Pole (DR2/207), S28°W 58.00'

Description of corner evidence found and/or method applied in restoring or reestablishing corner:

K-7 (T45N, R1E)

This corner is being perpetuated as part of the Chippewa County Remonumentation Program.

Found a 1/2" iron pin with plastic cap #29251 (Larry R. Rogers) in a monument box 2.4 feet south of centerline of east-west asphalt road (15 Mile Road). 15 Mile Road has been repaved since previous recording. Distances to two remaining witnesses from previous recording (red pine and power pole) check well. Accepted corner as found and established new witness objects.

Description of monument for corner and accessories established to perpetuate locating the position of the corner:

K-7 (T45N, R1E)


PK nail in power pole (DR2-207), S33°W 58.06' Note: Trees are blazed and painted. Bearings are
Nail w/tag #29251 10" Spruce, S28°E 56.08' compass bearings corrected
Nail w/tag #33142 in 14" Red Pine, S54°E 83.81' for declination.
Nail w/tag #33142 in 10" Spruce, N42°W 75.47'

Recorded by *Keith R. Waters*

Date *12-30-93*

Surveyor's Michigan License No. 33142

	A	B	C	D	E	F	G	H	I	J	K	L	M
2	6		5		4		3		2		1		
3													
4	7		8		9		10		11		12		
5													
6	18		17		16		15		14		13		
7													
8	19		20		21		22		23		24		
9													
10	30		29		28		27		26		25		
11													
12	31		32		33		34		35		36		
13													

Waters
12/14/93