

LAND CORNER RECORDATION CERTIFICATE
Filing Requirement of Act 74, Mich. P.A. 1970 as Amended

For corners in

Chippewa Located In: Corner Code #
 (County)

1. Public Land Survey T45N R 01E K11
 T ___ R ___
 T ___ R ___

2. Property Controlling S 26 T 45N R 01E 14
 in Section S ___ T ___ R ___
 S ___ T ___ R ___

3. Miscellaneous S ___ T ___ R ___
 Property in Sec. S ___ T ___ R ___

Register of Deeds Stamp & File
Number

4. Lot No. _____, Recorded Plat _____
 5. Private Claims

I, Stephan J. Szyszkoski, in a field survey on July 18, 2007 do hereby state that under requirements of P.A. 74, Michigan P.A. of 1970, the corner points mentioned in lines 1 and 2 above were in conformance with regulations and rules therefore as required in the current manual of survey instructions of the United States Department of the Interior, Bureau of Land Management or by a decree of a Court of Law and /or that the corner points mentioned in lines 3, 4 and 5 above were in conformance with the rules of the Michigan Board of Land Surveyors or by a Decree of a Court of Law; established, re-established, monumented, recovered, found as expressed below:

1	A	B	C	D	E	F	G	H	I	J	K	L	M
2	6			5		4		3		2		1	
3													
4	7			8		9		10		11		12	
5													
6	18			17		16		15		14		13	
7													
8	19			20		21		22		23		24	
9													
10	30			29		28		27		26		25	
11													
12	31			32		33		34		35		36	
13													

NOTE: Not more than 2 corners, all in the same town and range, may be recorded on this certificate.

A. Description of original monument and accessories and/or subsequent restoration:


(K11) Corner common to Sections 25-26-35-36. 1984 - D.B.Babbitt RLS restored the corner at "old post point in center line of abandoned road grade west and in line with an old fence running Northerly. I presume this to be the location of the corner described in the County Surveyors record dated 1907 in which he states that he ran the South line of Sec. 26 "for highway on S. line" and that the original bearing trees for the S.E. Sec. Cor. were standing at the time of his survey. He does not note any NBTs". Set 1" I.pipe with 4" aluminum MDNR cap. NBTs: 14" Spruce N72W 55.6', 5" Tamarack N63W 32.6', 16" Tamarack N30E 13.0', 7" Spruce S85E 53.5'.
 (14-Sec. 26) South 1/16 corner between Sections 25 and 26. 1984 - Established by D.B.Babbitt RLS midway and on line between Section corner to south and Quarter corner to north. Set 1" IDx36" I.pipe with 4" alum. MDNR cap. 10" Aspen S16E 98.7', Tag in Fence Post S15W 86.0', 8" Aspen S27W 96.2', 6" Balsam S38W 100.6'

B. Description of corner evidence found and/or method applied in restoring or reestablishing corner:

(K11) Recovered the 1984 monument in good condition and at record bearing and distance from the 1984 NBTs. The two Tamarack NBTs are in good condition with markings visible. The Spruce NBTs are dead and down. Accepted the monument as the best available evidence of the position of the original corner.
 (14-Sec. 26) The 1984 monument was not recovered and has likely been removed by farming activity. Reestablished the position for the corner from the remaining 1984 witness trees Balsam S38W, found in good condition, and Aspen S16E, found stump with bottom blaze plain. The fence post noted in 1984 is gone and the Aspen S27W has been blown down.

C. Description of monument for corner and accessories established to perpetuate locating the position of the corner:

(K11) Found 1" ID I.pipe with 4" alum. MDNR cap. Set measuring nails in the following:	(14) Set 1" IDx36" I.Pipe with 4" alum. MDNR cap. Set measuring nails with MDNR tags in the following:
11" Tamarack N60W 32.75' mrkd "S25" (1984 NBT)	12" Balsam S37W 101.1' mrkd "S1/16" (1984 BT)
19" Tamarack N32E 13.82' with old blaze do	4" Aspen S18E 69.2' "S1/16 BT"
5" Spruce S75W 16.83' mrkd "S35 NBT"	6" Aspen S5W 57.6' do
5" Spruce in clump S42E 2.05' mrkd "S36 NBT"	13" Aspen S52W 19.6' do
Bearings are magnetic. Distances are to nail with tag in the side of the tree.	Bearings are magnetic. Distances are to nail with tag in the side of the tree.

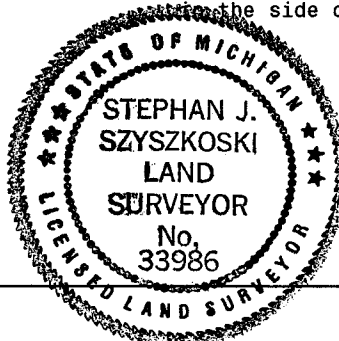

Signed by Stephan J. Szyszkoski Date 9/11/07

Surveyor's Michigan License No. 33986