

**SURVEY & REMONUMENTATION**

APR 26 1995

CHIPPEWA COUNTY REMONUMENTATION CORNER

COMMISSION

LAND CORNER RECORDATION CERTIFICATE


Filing Requirement of Act 74, Mich. P.A. 1970

For corners in

<u>Chippewa</u> (County)	Located In:	Corner Code #
1. Public Land Survey	T <u>45N</u> R <u>1W</u>	<u>B-1</u>
	T _____ R _____	_____
	T _____ R _____	_____
	T _____ R _____	_____
2. Property Controlling in Section	S _____ T _____ R _____	_____
	S _____ T _____ R _____	_____
3. Miscellaneous Property in Sec.	S _____ T _____ R _____	_____
	S _____ T _____ R _____	_____
4. Lot No. _____, Recorded Plat _____		
5. Private Claims _____		

\$ 7.00 LAND CORNER  
 \$ 2.00 MSSR  
 5 DEC 94 12:25 P.M. RECEIPT# 1518  
 RECEIVED FOR RECORD  
 CHIPPEWA COUNTY - STATE OF MICHIGAN  
 SHARON H. KENNEDY, REGISTER OF DEEDS  
**Register of Deeds Stamp & File Number**


I, William L. Karr, in a field survey on October 28, 1994, do hereby certify that under requirements of P.A. 74, Michigan P.A. of 1970, the corner points mentioned in lines 1 and 2 above were in conformance with regulations and rules therefore as required in the current manual of survey instructions of the United States Department of the Interior, Bureau of Land Management or by a decree of a Court of Law and/or that the corner points mentioned in lines 3, 4 and 5 above were in conformance with the rules of the Michigan Board of Land Surveyors or by a Decree of a Court of Law; established, re-established, monumented, re-monumented, recovered, found as expressed below:

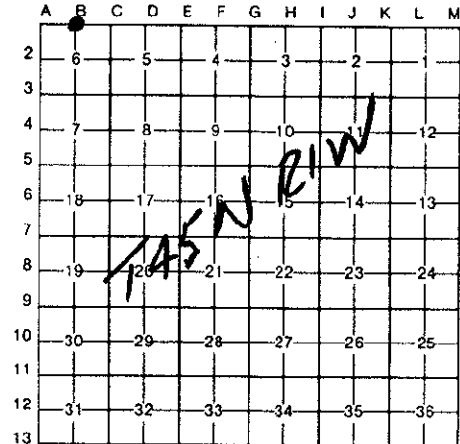

**NOTE: Not more than 4 corners, all in the same town and range, may be recorded on this certificate.**

A. Description of original monument and accessories and/or subsequent restoration:  
(B-1) North 1/4 Corner Section 6, T.45 N., R.1 W. (Not common)

Not set in original survey

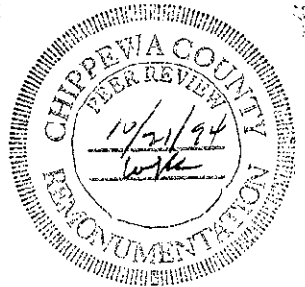

B. Description of corner evidence found and/or method applied in restoring or reestablishing corner:

(B-1) This corner is being established as part of the Chippewa County Remonumentation program.

Established this corner on Township line by pro-rating GLO distance between Township corner and Closing Corner 6/5. (GLO was 5248.32'; today is 5263.70') Corner falls 14.63' East of the South 1/4 corner of Section 31.

C. Description of monument for corner and accessories established to perpetuate locating the position of the corner:

(B-1) Corner is a 3/4"x 24" iron with aluminum "Chippewa County Remonumentation cap and falls approximately 25' South of an old 2 track.

Witnesses: 7" Balsam Fir	N06°W	8.09'
6" Balsam Fir	N57°E	18.03'
6" Maple	S69°E	10.22'
8" Maple	S05°E	13.41'
South 1/4 Corner Section 31	West	14.63'



Signed by William L. Karr Date 12/2/94

Surveyor's Michigan License No. 27450

723-12

FORM APPROVED BY MICHIGAN STATE BOARD OF LAND SURVEYORS, JAN. 28, 1971  
 REVISED MAY 14, 1975  
 REVISED JAN., 1983

**NOTE: Bearings are compass bearings corrected for declination.  
 Distances are to a nail in side of witness objects unless noted.**