

**SURVEY & REMONUMENTATION**

**CHIPPEWA COUNTY REMONUMENTATION CORNER**

APR 26 1995


**LAND CORNER RECORDATION CERTIFICATE**  
 Filing Requirement of Act 74, Mich. P.A. 1970

For corners in **CHIPPEWA** COMMISSION

Located In: \_\_\_\_\_ Corner Code # \_\_\_\_\_

(County) \_\_\_\_\_

1. Public Land Survey	T	45N	R	1W	B-7
	T		R		
	T		R		
	T		R		
2. Property Controlling in Section	S		T	R	
	S		T	R	
3. Miscellaneous Property in Sec.	S		T	R	
	S		T	R	
4. Lot No. _____, Recorded Plat _____					
5. Private Claims _____					

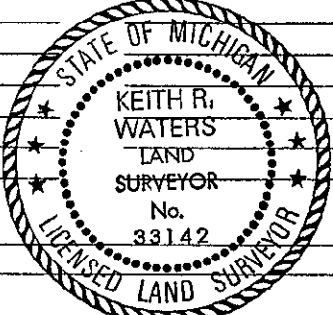

\$ 7.00 LAND CORNER  
 \$ 2.00 MSSR  
 19 JAN 95 4:09 P.M. RECEIPT# 2266  
 RECEIVED FOR RECORD  
 CHIPPEWA COUNTY - STATE OF MICHIGAN  
 SHARON H. KENNEDY, REGISTER OF DEEDS  
**Register of Deeds Stamp & File Number**

	A	B	C	D	E	F	G	H	I	J	K	L	M
2	6		5		4		3		2		1		
3													
4	7		8		9		10		11		12		
5													
6	18		17		16		15		14		13		
7													
8	19		20		21		22		23		24		
9													
10	30		29		28		27		26		25		
11													
12	31		32		33		34		35		36		

**Keith R. Waters** December 1 1994  
 I, \_\_\_\_\_, in a field survey on \_\_\_\_\_, 19\_\_\_\_,  
 do hereby certify that under requirements of P.A. 74, Michigan P.A. of 1970, the corner points mentioned in lines 1 and 2 above were in conformance with regulations and rules therefore as required in the current manual of survey instructions of the United States Department of the Interior, Bureau of Land Management or by a decree of a Court of Law and/or that the corner points mentioned in lines 3, 4 and 5 above were in conformance with the rules of the Michigan Board of Land Surveyors or by a Decree of a Court of Law; established, re-established, monumented, re-monumented, recovered, found as expressed below:

**NOTE: Not more than 4 corners, all in the same town and range, may be recorded on this certificate.**

A. Description of original monument and accessories and/or subsequent restoration:  
 B-7 1/4 Corner Common to Sections 18 & 19, T45N, R1W.

Original ties to post: Spruce 10, N23°E 10 links Hemlock 12, S47°E 26 links. 1991 - As recorded in liber 7, page 334, Chippewa County corner records, by Keith Waters, P.S. 33142. Set 1/2" iron with cap #33142 by single proportionate measurement between northwest and northeast corners of Section 19. Witnesses: 8" White Pine, NORTH 27.10' 10" White Pine, N36°E 41.70' 6" Black Spruce, S18°W 23.60' 6" White Pine, S88°E 58.00'

B. Description of corner evidence found and/or method applied in restoring or reestablishing corner:  
 B-7 (T45N, R1W)  
 This corner is being perpetuated as part of the Chippewa County Remonumentation Program. Found a 1/2" iron with plastic cap #33142 and all four bearing trees as called for in liber 7, page 334. Corner was established by single proportionate measurement on line between Section corners 2653.71 feet east and 2603.96 feet west. G.L.O. distances were 2640 feet east and 2590.5 feet west.



C. Description of monument for corner and accessories established to perpetuate locating the position of the corner:  
 B-7 (T45N, R1W)  
 Corner is a 1/2" iron with plastic cap #33142. Witnesses:  
 8" White Pine, NORTH 27.10'  
 10" White Pine, N36°E 41.70'  
 6" Black Spruce, S18°W 23.60'  
 6" White Pine, S88°E 58.00'

Note: Distances are to a nail in the side of the tree. Trees are blazed and painted. Bearings are compass bearings corrected for declination.

Signed by Keith R. Waters Date 12-23-94  
 Surveyor's Michigan License No. 33142