

SURVEY & REMONUMENTATION

APR 26 1995

CHIPPEWA COUNTY REMONUMENTATION CORNER

COMMISSION

LAND CORNER RECORDATION CERTIFICATE
Filing Requirement of Act 74, Mich. P.A. 1970


For corners in
Chippewa

(County)

Located In:

Corner Code **B-11**

- 1. Public Land Survey T 45N R 1W B-11
- 2. Property Controlling in Section S T R
- 3. Miscellaneous Property in Sec. S T R
- 4. Lot No. _____, Recorded Plat _____
- 5. Private Claims _____

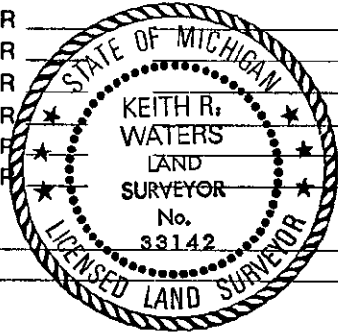

\$ 7.00 LAND CORNER
\$ 2.00 HSSR
19 JAN 95 4:10 P.M. RECEIPT# 2266
RECEIVED FOR RECORD
CHIPPEWA COUNTY - STATE OF MICHIGAN
SHARON H. KENNEDY, REGISTER OF DEEDS
Register of Deeds Stamp & File Number

	A	B	C	D	E	F	G	H	I	J	K	L	M
2	6	5	4	3	2	1							
3													
4	7	8	9	10	11	12							
5													
6	18	17	16	15	14	13							
7													
8	19	20	21	22	23	24							
9													
10	30	29	28	27	26	25							
11	●												
12	31	32	33	34	35	36							
13													

I, **Keith R. Waters** in a field survey on **November 30**, 19 **94**, do hereby certify that under requirements of P.A. 74, Michigan P.A. of 1970, the corner points mentioned in lines 1 and 2 above were in conformance with regulations and rules therefore as required in the current manual of survey instructions of the United States Department of the Interior, Bureau of Land Management or by a decree of a Court of Law and/or that the corner points mentioned in lines 3, 4 and 5 above were in conformance with the rules of the Michigan Board of Land Surveyors or by a Decree of a Court of Law; established, re-established, monumented, re-monumented, recovered, found as expressed below:

NOTE: Not more than 4 corners, all in the same town and range, may be recorded on this certificate.

A. Description of original monument and accessories and/or subsequent restoration:

B-11 1/4 Corner Common to Sections 30 & 31, T45N, R1W.

Original ties to post: Birch 20, N31°W 13 links Birch 24, S31°E 04 links
1978 - As recorded in liber 1, page 365, Chippewa County corner records, by Thomas Kelly, RLS 24599. Set concrete monument by single proportionate measurement. Witnesses: 5" White Pine, N47°E 282.00' Bell Telephone Cable Route Marking Post, N80°E 75.65' NW Cor. Bldg. 100, S54°E 445.30'
1981 - Corner is shown on recorded plat of Chippewa County Industrial Air Park Plat.

B. Description of corner evidence found and/or method applied in restoring or reestablishing corner:

B-11 (T45N, R1W)

This corner is being perpetuated as part of the Chippewa County Remonumentation Program.

Found a 4" diameter concrete monument with a 1/2" iron and plastic cap #24599 and all three witness objects as called for in liber 1, page 365. Corner falls inside the fenced area of the Chippewa County International Airport, north and east of the north end of the runway. Accepted corner as found. (Tree shown in liber 1, page 365, as a white pine is actually a red pine).


C. Description of monument for corner and accessories established to perpetuate locating the position of the corner:

B-11 (T45N, R1W)

Corner is a 4" diameter concrete monument with 1/2" iron and cap #24599 on the grounds of the Chippewa County International Airport. Witnesses:

- Michigan Bell Underground Cable Route Marking Post, N80°E 75.67'
- 13" Red Pine, N51°E 281.96'
- 12" Red Pine, N62°E 269.22'
- NW Corner Bldg. 100, S50°E 445.18' (Corner of Metal Siding)

Note: Distances to post and trees are to a nail and side in the side. Trees are blazed and painted. Bearings are compass bearings corrected for declination.

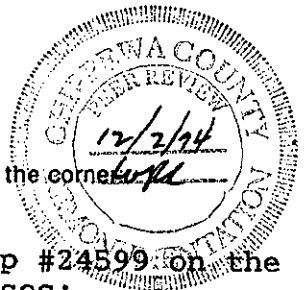

Signed by Keith R. Waters

Date 12-23-94

Surveyor's Michigan License No. 33142