

SURVEY & REMONUMENTATION

APR 26 1995

CHIPPEWA COUNTY REMONUMENTATION CORNER

COMMISSION


LAND CORNER RECORDATION CERTIFICATE

Filing Requirement of Act 74, Mich. P.A. 1970

For corners in
Chippewa
(County)

Located In: _____ Corner Code # _____

- 1. Public Land Survey T 45N R 1W C-8
T _____ R _____
T _____ R _____
T _____ R _____
- 2. Property Controlling in Section S _____ T _____ R _____
S _____ T _____ R _____
- 3. Miscellaneous Property in Sec. S _____ T _____ R _____
S _____ T _____ R _____
- 4. Lot No. _____, Recorded Plat _____
- 5. Private Claims _____

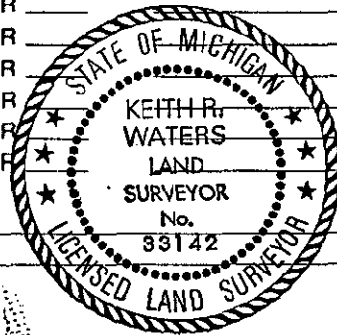

\$ 7.00 LAND CORNER
\$ 2.00 MSSR
19 JAN 95 4:11 P.M. RECEIPT# 2266
RECEIVED FOR RECORD
CHIPPEWA COUNTY - STATE OF MICHIGAN
SHARON H. KENNEDY, REGISTER OF DEEDS

Register of Deeds Stamp & File Number

	A	B	C	D	E	F	G	H	I	J	K	L	M
2	6		5		4		3		2		1		
3													
4	7		8		9		10		11		12		
5													
6	16		17		18		15		14		13		
7													
8	19		20		21		22		23		24		
9													
10	30		29		28		27		26		25		
11													
12	31		32		33		34		35		36		
13													

I, Keith R. Waters in a field survey on December 6, 19 94, do hereby certify that under requirements of P.A. 74, Michigan P.A. of 1970, the corner points mentioned in lines 1 and 2 above were in conformance with regulations and rules therefore as required in the current manual of survey instructions of the United States Department of the Interior, Bureau of Land Management or by a decree of a Court of Law and/or that the corner points mentioned in lines 3, 4 and 5 above were in conformance with the rules of the Michigan Board of Land Surveyors or by a Decree of a Court of Law; established, re-established, monumented, re-monumented, recovered, found as expressed below:

NOTE: Not more than 4 corners, all in the same town and range, may be recorded on this certificate.

A. Description of original monument and accessories and/or subsequent restoration:

C-8 1/4 Corner Common to Sections 19 & 20, T45N, R1W.

Original ties to post: Birch 6, N53°E 11 links Birch 5, S42°W 13 links
1980 - Corner is shown on a drawing of Section 20 by Thomas Kelly, RLS 24599, as being mid-way on line between section corners 2639.54 feet N. & S.
1991 - As recorded in liber 7, page 336, Chippewa County corner records, by Keith Waters, P.S. 33142. Set corner using found monumentation as shown on above mentioned Kelly drawing. Also found 3 existing bearing trees. Position checks well with section corners north and south.

B. Description of corner evidence found and/or method applied in restoring or reestablishing corner:

C-8 (T45N, R1W)

This corner is being perpetuated as part of the Chippewa County Remonumentation Program.
Found a 1/2" iron with plastic cap #33142 and all four bearing trees as called for in liber 7, page 336. Corner falls on the east side of a large area of mounds in a former landfill area.

C. Description of monument for corner and accessories established to perpetuate locating the position of the corner:

C-8 (T45N, R1W)

Corner is 1/2" iron with plastic cap #33142. Witnesses:

- 10" Oak, N17°E 245.97'
- 22" White Pine, N33°W 128.30'
- 8" Aspen, S80°W 57.80'
- 12" Oak, S10°W 154.10'

Note: Distances to first three trees are to a nail and cap #24599 in the side. Distance to 12" oak is to a nail in side. Trees are blazed and painted. Bearings are compass bearings corrected for declination.

Signed by Keith R. Waters

Date 12-23-94

Surveyor's Michigan License No. 33142

