

**SURVEY & REMONUMENTATION**

**CHIPPEWA COUNTY REMONUMENTATION CORNER**

APR 26 1995

**LAND CORNER RECORDATION CERTIFICATE**

Filing Requirement of Act 74, Mich. P.A. 1970

**COMMISSION**

For corners in Chippewa

(County)

Located In:

Corner Code #

1. Public Land Survey

T 45N R 1W C-9

T \_\_\_\_\_ R \_\_\_\_\_

T \_\_\_\_\_ R \_\_\_\_\_

T \_\_\_\_\_ R \_\_\_\_\_

2. Property Controlling in Section

S \_\_\_\_\_ T \_\_\_\_\_ R \_\_\_\_\_

S \_\_\_\_\_ T \_\_\_\_\_ R \_\_\_\_\_


3. Miscellaneous Property in Sec.

S \_\_\_\_\_ T \_\_\_\_\_ R \_\_\_\_\_

S \_\_\_\_\_ T \_\_\_\_\_ R \_\_\_\_\_

4. Lot No. \_\_\_\_\_, Recorded Plat \_\_\_\_\_

5. Private Claims \_\_\_\_\_

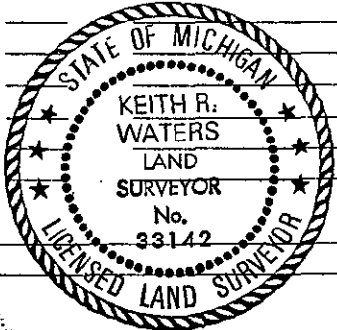

\$ 7.00 LAND CORNER  
\$ 2.00 MSSR  
19 JAN 95 4:11 P.M. RECEIPT# 2266  
RECEIVED FOR RECORD  
CHIPPEWA COUNTY - STATE OF MICHIGAN  
SHARON H. KENNEDY, REGISTER OF DEEDS

Register of Deeds Stamp & File Number

	A	B	C	D	E	F	G	H	I	J	K	L	M
2	6		5		4		3		2		1		
3													
4	7		8		9		10		11		12		
5													
6	18		17		16		15		14		13		
7													
8	19		20		21		22		23		24		
9													
10	30		29		28		27		26		25		
11													
12	31		32		33		34		35		36		
13													

I, Keith R. Waters in a field survey on November 23, 1994, do hereby certify that under requirements of P.A. 74, Michigan P.A. of 1970, the corner points mentioned in lines 1 and 2 above were in conformance with regulations and rules therefore as required in the current manual of survey instructions of the United States Department of the Interior, Bureau of Land Management or by a decree of a Court of Law and/or that the corner points mentioned in lines 3, 4 and 5 above were in conformance with the rules of the Michigan Board of Land Surveyors or by a Decree of a Court of Law; established, re-established, monumented, re-monumented, recovered, found as expressed below:

**NOTE: Not more than 4 corners, all in the same town and range, may be recorded on this certificate.**

A. Description of original monument and accessories and/or subsequent restoration:

C-9 Corner Common to Sections 19, 20, 29, & 30, T45N, R1W.

Original ties to post: White Pine 20, S73°W 6 links Birch 12, S88°W 20 links 1978 - As recorded in liber 1, page 363, Chippewa County corner records, by Thomas Kelly, RLS 24599. Found 4" square stamped plate set by U.S. Air Force. Witnesses: PK Nail, EAST 80.90' Power Pole(8), S62°W 39.00' Power Pole(9), N13°W 86.50'.

B. Description of corner evidence found and/or method applied in restoring or reestablishing corner:

C-9 (T45N, R1W)

This corner is being perpetuated as part of the Chippewa County Remonumentation Program.

Found a stamped 3½" x 2½" rectangular iron and two power pole witness objects as shown in liber 1, page 363. Corner was set by the United States Air Force when this area was part of the Kincheloe Air Force Base. Accepted corner as found and established new witness objects.



C. Description of monument for corner and accessories established to perpetuate locating the position of the corner

C-9 (T45N, R1W)

Corner is a stamped 3½" x 2½" rectangular iron approximately 80 feet west of the centerline of a north-south asphalt drive inside the fenced area of the former Kinross Manufacturing complex. Witnesses:

- Power Pole (8), S58°W 39.22'
- Power Pole (9), N29°W 86.92'
- Power Pole, N88°W 91.34'
- Power Pole, S23°W 77.64'

Note: Distances are to a nail and tag in the side of witness object. Bearings are compass bearings corrected for declination

Signed by Keith R. Waters

Date 12-23-94

Surveyor's Michigan License No. 33142