

**SURVEY &  
REMONUMENTATION**

**CHIPPEWA COUNTY REMONUMENTATION CORNER**


APR 26 1995

**LAND CORNER RECORDATION CERTIFICATE  
Filing Requirement of Act 74, Mich. P.A. 1970**

For corner of **COMMISSION**  
**Chippewa**

Located In: Corner Code #

1. Public Land Survey T 45N R 1W C-12  
 T \_\_\_\_\_ R \_\_\_\_\_  
 T \_\_\_\_\_ R \_\_\_\_\_  
 T \_\_\_\_\_ R \_\_\_\_\_  
 T \_\_\_\_\_ R \_\_\_\_\_
2. Property Controlling S \_\_\_\_\_ T \_\_\_\_\_ R \_\_\_\_\_  
 in Section S \_\_\_\_\_ T \_\_\_\_\_ R \_\_\_\_\_
3. Miscellaneous S \_\_\_\_\_ T \_\_\_\_\_ R \_\_\_\_\_  
 Property in Sec. S \_\_\_\_\_ T \_\_\_\_\_ R \_\_\_\_\_
4. Lot No. \_\_\_\_\_, Recorded Plat \_\_\_\_\_
5. Private Claims \_\_\_\_\_

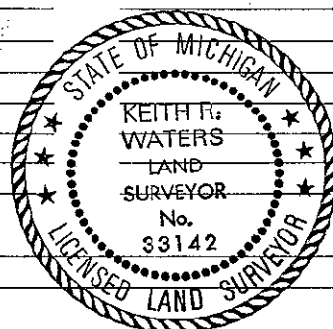

\$ 7.00 LAND CORNER  
 \$ 2.00 MSSR  
 5 DEC 94 12:34 P.M. RECEIPT# 1520  
 RECEIVED FOR RECORD  
 CHIPPEWA COUNTY - STATE OF MICHIGAN  
 SHARON H. KENNEDY, REGISTER OF DEEDS

Register of Deeds Stamp & File Number

	A	B	C	D	E	F	G	H	I	J	K	L	M
2	6	5	4	3	2	1							
3													
4	7	8	9	10	11	12							
5													
6	18	17	16	15	14	13							
7													
8	19	20	21	22	23	24							
9													
10	30	29	28	27	26	25							
11													
12	31	32	33	34	35	36							
13													

I, Keith R. Waters in a field survey on October 4, 1994, do hereby certify that under requirements of P.A. 74, Michigan P.A. of 1970, the corner points mentioned in lines 1 and 2 above were in conformance with regulations and rules therefore as required in the current manual of survey instructions of the United States Department of the Interior, Bureau of Land Management or by a decree of a Court of Law and/or that the corner points mentioned in lines 3, 4 and 5 above were in conformance with the rules of the Michigan Board of Land Surveyors or by a Decree of a Court of Law; established, re-established, monumented, re-monumented, recovered, found as expressed below:

**NOTE: Not more than 4 corners, all in the same town and range, may be recorded on this certificate.**


A. Description of original monument and accessories and/or subsequent restoration:

C-12 1/4 Corner Common to Sections 31 & 32, T45N, R1W.

Original ties to post: Birch 15, S49°W 26 links - Hemlock 12, N56°E 17 links. 1978 - As recorded in liber 1, page 362, Thomas M. Kelly, RLS 24599. Set 1/2" iron in concrete taxiway. Witnesses: PK nail, NORTH 60.39' - PK nail, EAST 38.07' - PK nail, N30°W 74.82'. Set by single proportionate measurement between Section corners 1/2 mile north and south. 1980 - Corner is referenced in the Kinross Township Industrial Plat No. 1.

B. Description of corner evidence found and/or method applied in restoring or reestablishing corner:

C-12 (T45N, R1W)  
 This corner is being perpetuated as part of the Chippewa County Remonumentation Program.  
 Found a 1/2" iron with plastic cap #24599 in concrete mass ramp in a fenced area at the Chippewa County International Airport, west of Building #425. Did not find PK nails shown as witnesses in liber 1, page 362. Corner position fits with other corners in area as shown on a sketch by Thomas M. Kelly, RLS 24599. Accepted corner as found and established new witness objects.

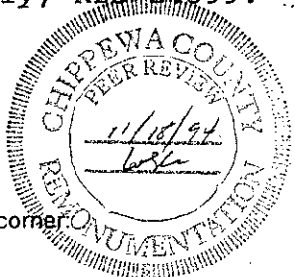

C. Description of monument for corner and accessories established to perpetuate locating the position of the corner:

C-12 (T45N, R1W)  
 Corner is 1/2" iron with plastic cap #24599 in concrete mass ramp west of Building #425 at the Chippewa County International Airport. Witnesses:  
 Center of 4" Diameter Gate Post (Northerly Gate Post), N84°W 480.98'  
 Northwest Bolt in Light Pole Base, N85°E 482.46'  
 Northwest Bolt in Light Pole Base, S60°E 590.44'  
 Center of Top Bolt on Hydrant west side of Building #425, S85°E 692.82'

Note: Distances measured with EDM, bearings are compass bearings corrected for declination.

Signed by Keith R. Waters Date 12-1-94  
 Surveyor's Michigan License No. 33142