

SURVEY & REMONUMENTATION

APR 26 1995

CHIPPEWA COUNTY REMONUMENTATION CORNER


COMMISSION

LAND CORNER RECORDATION CERTIFICATE
Filing Requirement of Act 74, Mich. P.A. 1970

For corners in
Chippewa
(County)

Located In: _____ Corner Code # _____

- 1. Public Land Survey T45N R1W C-13
T _____ R _____
T _____ R _____
T _____ R _____
- 2. Property Controlling in Section S _____ T _____ R _____
S _____ T _____ R _____
- 3. Miscellaneous Property in Sec. S _____ T _____ R _____
S _____ T _____ R _____
- 4. Lot No. _____, Recorded Plat _____
- 5. Private Claims _____

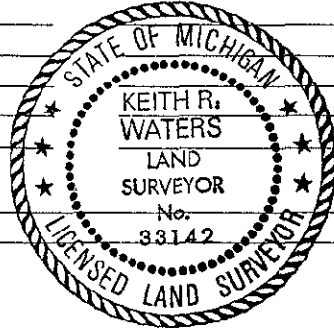

\$ 7.00 LAND CORNER
\$ 2.00 MSSR
24 OCT 94 3:47 P.M. RECEIPT# 831
RECEIVED FOR RECORD
CHIPPEWA COUNTY - STATE OF MICHIGAN
SHARON H. KENNEDY, REGISTER OF DEEDS
Register of Deeds Stamp & File Number

	A	B	C	D	E	F	G	H	I	J	K	L	M
2	6	5	4	3	2	1							
3													
4	7	8	9	10	11	12							
5													
6	18	17	16	15	14	13							
7													
8	19	20	21	22	23	24							
9													
10	30	29	28	27	26	25							
11													
12	31	32	33	34	35	36							
13													

I, Keith R. Waters in a field survey on September 29, 1994, do hereby certify that under requirements of P.A. 74, Michigan P.A. of 1970, the corner points mentioned in lines 1 and 2 above were in conformance with regulations and rules therefore as required in the current manual of survey instructions of the United States Department of the Interior, Bureau of Land Management or by a decree of a Court of Law and/or that the corner points mentioned in lines 3, 4 and 5 above were in conformance with the rules of the Michigan Board of Land Surveyors or by a Decree of a Court of Law; established, re-established, monumented, re-monumented, recovered, found as expressed below:

NOTE: Not more than 4 corners, all in the same town and range, may be recorded on this certificate.

A. Description of original monument and accessories and/or subsequent restoration:

C-13 Corner Common to Sections 31 & 32, on South Boundary of T45N, R1W.
(Standard Corner on Township Line)
Original ties to post: Maple 10, N06°E 33 links
Fir 7, N03°W 7 links
1978 - Corner recorded in liber 1, page 361, Chippewa County corner records, T. Kelly, RLS 24599, set ½" iron with cap. Witnesses: PK nail in asphalt, NORTH 37.21' - PK nail in asphalt, S52°E 28.83' - PK nail in asphalt, N82°W 23.41'.

B. Description of corner evidence found and/or method applied in restoring or reestablishing corner:

C-13 (T45N, R1W)
This corner is being perpetuated as part of the Chippewa County Remonumentation Program.
Found a ½" iron with plastic cap in a paved area on the east side of the north-south runway of the Chippewa County International Airport, on the north side of an east-west taxiway. Also found three PK nails as called for in previous recording. Corner was established by single proportionate measurement on the township line between township corner to the west and common corner to Sections 33 & 34, T45N, R1W and Sections 3 & 4, T44N, R1W to the east. Accepted corner as found and established new witness objects.
(Note: Closing corner to Sections 5-6, T44N, R1W is 16.50 feet east).

C. Description of monument for corner and accessories established to perpetuate locating the position of the corner:

C-13 (T45N, R1W)
Corner is ½" iron with plastic cap on the east side of the north-south runway, on the north side of east-west taxiway. Witnesses:
PK nail in asphalt, N02°W 37.21' N.W. corner of 10" x 54" sign (B1-34-16)
PK nail in asphalt, N82°W 23.41' on south side of taxiway, S75°E 210.70'
PK nail in asphalt, S56°E 28.81' N.E. corner of 10" x 32" sign (B1) on east side of runway, S45°W 79.59'

Note: Bearings are compass bearings corrected for declination.

Signed by Keith R. Waters Date 10-18-94
Surveyor's Michigan License No. 33142

