

SURVEY & REMONUMENTATION

APR 26 1995

CHIPPEWA COUNTY REMONUMENTATION CORNER

LAND CORNER RECORDATION CERTIFICATE

Filing Requirement of Act 74, Mich. P.A. 1970

COMMISSION

For corners in

Chippewa (County)	Located In:	Corner Code #
1. Public Land Survey	T <u>45N</u> R <u>1W</u>	D-1
	T _____ R _____	_____
	T _____ R _____	_____
	T _____ R _____	_____
2. Property Controlling in Section	S _____ T _____ R _____	_____
	S _____ T _____ R _____	_____
3. Miscellaneous Property in Sec.	S _____ T _____ R _____	_____
	S _____ T _____ R _____	_____

\$ 7.00 LAND CORNER
 \$ 2.00 MSSR
 5 DEC 94 12:26 P.M. RECEIPT# 1518
 RECEIVED FOR RECORD
 CHIPPEWA COUNTY - STATE OF MICHIGAN
 SHARON H. KENNEDY, REGISTER OF DEEDS

Register of Deeds Stamp & File Number


4. Lot No. _____, Recorded Plat _____
 5. Private Claims _____

I, William L. Karr, in a field survey on October 28, 19 94, do hereby certify that under requirements of P.A. 74, Michigan P.A. of 1970, the corner points mentioned in lines 1 and 2 above were in conformance with regulations and rules therefore as required in the current manual of survey instructions of the United States Department of the Interior, Bureau of Land Management or by a decree of a Court of Law and/or that the corner points mentioned in lines 3, 4 and 5 above were in conformance with the rules of the Michigan Board of Land Surveyors or by a Decree of a Court of Law; established, re-established, monumented, re-monumented, recovered, found as expressed below:

NOTE: Not more than 4 corners, all in the same town and range, may be recorded on this certificate.

A. Description of original monument and accessories and/or subsequent restoration:
(D-1) North 1/4 Corner Section 5, T.45 N., R.1 W. (Not common)

Not set in original survey

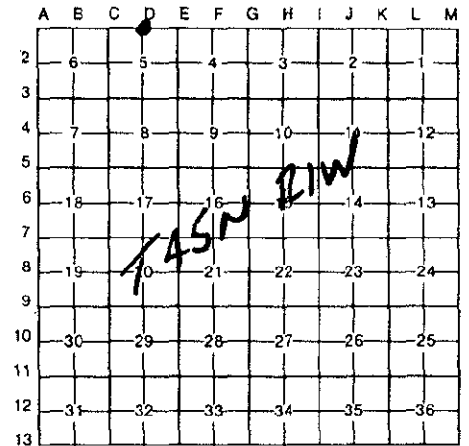


B. Description of corner evidence found and/or method applied in restoring or reestablishing corner:
(D-1) This corner is being established as part of the Chippewa County Remonumentation program.

Established corner on Township line using the South 1/4 corner of Section 32 and Standard Corner 32/33 on the extension of a fenceline to the South. Corner falls 21.45 East of the South 1/4 corner of Section 32 and approximately 5' South of centerline of 2 track.

C. Description of monument for corner and accessories established to perpetuate locating the position of the corner:
(D-1) Corner is a 3/4"x 24" iron with aluminum "Chippewa County Remonumentation" cap on the extension of a fenceline to the South and approximately 5' South of the centerline of a two track.

Witnesses: 5" Spruce	N60°W	44.89'
5" Balsam Fir	S77°W	49.24'
12" Spruce	S57°E	27.15'
10" Spruce	N55°E	36.08'
South 1/4 corner Section 32	West	21.45'

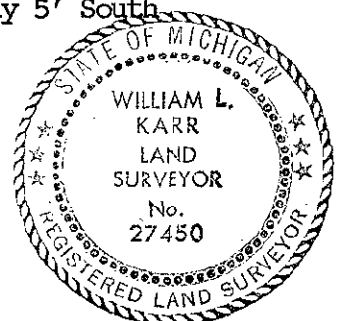

Signed by William L. Karr Date 12/2/94

Surveyor's Michigan License No. 27450

723-12

NOTE: Bearings are compass bearings corrected for declination.
 Distances are to a nail in side of witness objects unless noted.