

SURVEY & REMONUMENTATION

APR 26 1995

CHIPPEWA COUNTY REMONUMENTATION CORNER

COMMISSION

LAND CORNER RECORDATION CERTIFICATE
Filing Requirement of Act 74, Mich. P.A. 1970

For corners in
Chippewa

(County)

Located In:

Corner Code #

1. Public Land Survey

T 45N R 1W D-9

T R

T R

T R

2. Property Controlling in Section

S T

S T


3. Miscellaneous Property in Sec.

S T

S T

4. Lot No. , Recorded Plat

5. Private Claims

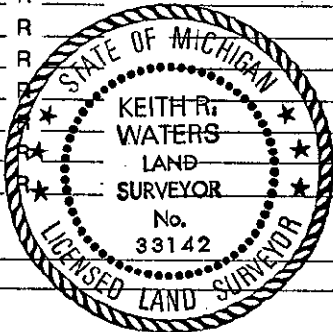

\$ 7.00 LAND CORNER
\$ 2.00 HSSR
19 JAN 95 4:12 P.M. RECEIPT# 2266
RECEIVED FOR RECORD
CHIPPEWA COUNTY - STATE OF MICHIGAN
SHARON H. KENNEDY, REGISTER OF DEEDS

Register of Deeds Stamp & File Number

	A	B	C	D	E	F	G	H	I	J	K	L	M
2	6		5	4	3	2	1						
3													
4	7	8	9	10	11	12							
5													
6	16	17	18	19	20	21	22	23	24				
7													
8	19	20	21	22	23	24							
9													
10	30	29	28	27	26	25							
11													
12	31	32	33	34	35	36							
13													

I, Keith R. Waters in a field survey on November 29, 19 94, do hereby certify that under requirements of P.A. 74, Michigan P.A. of 1970, the corner points mentioned in lines 1 and 2 above were in conformance with regulations and rules therefore as required in the current manual of survey instructions of the United States Department of the Interior, Bureau of Land Management or by a decree of a Court of Law and/or that the corner points mentioned in lines 3, 4 and 5 above were in conformance with the rules of the Michigan Board of Land Surveyors or by a Decree of a Court of Law; established, re-established, monumented, re-monumented, recovered, found as expressed below:

NOTE: Not more than 4 corners, all in the same town and range, may be recorded on this certificate.

A. Description of original monument and accessories and/or subsequent restoration:

D-9 1/4 Corner Common to Sections 20 & 29, T45N, R1W.

Original ties to post: White Pine 18, S12°W 30 links Hemlock, N17°E 26 links 1978 - As recorded in liber 1, page 360, Chippewa County corner records, by Thomas Kelly, RLS 24599. Set concrete monument by single proportionate measurement. Witnesses: 8" Maple, N80°E 19.90' Group of 5" Maples, S13°E 60.98' Group of Maples, N30°W 55.60'.
1982 - Corner is shown on recorded plat of Cedar Grove Estates No. 3.

B. Description of corner evidence found and/or method applied in restoring or reestablishing corner:

D-9 (T45N, R1W)

This corner is being perpetuated as part of the Chippewa County Remonumentation Program.

Found a 4" diameter concrete monument with a 1/2" iron and plastic cap #24599 and all three bearing trees as called for in liber 1, page 360. Corner falls on the grounds of the Kincheloe Memorial Public Golf Course. Accepted corner as found.

C. Description of monument for corner and accessories established to perpetuate locating the position of the corner:

D-9 (T45N, R1W)

Corner is a 4" diameter concrete monument with 1/2" iron and cap #24599 on the east side of the Kincheloe Golf Course. Witnesses:

Group of 4"-8" Maples, S01°E 60.95'
10" Maple, S88°E 19.85'
Triple 8" Maple, N43°E 29.30'
Group of 8"-10" Maples, N22°W 55.19'

Note: Distances are to a nail and tag in the side of tree. Bearings are compass bearings corrected for declination. Trees are not blazed, due to corner location in residential subdivision/golf course area.

Signed by Keith R. Waters

Date 12-23-94

Surveyor's Michigan License No. 33142

