

**SURVEY & REMONUMENTATION**

**CHIPPEWA COUNTY REMONUMENTATION CORNER**

APR 26 1995

**LAND CORNER RECORDATION CERTIFICATE**

Filing Requirement of Act 74, Mich. P.A. 1970

**COMMISSION**

For corners in Chippewa

Located In: \_\_\_\_\_ Corner Code # \_\_\_\_\_

(County) \_\_\_\_\_


1. Public Land Survey T 45N R 1W D-11  
 T \_\_\_\_\_ R \_\_\_\_\_  
 T \_\_\_\_\_ R \_\_\_\_\_  
 T \_\_\_\_\_ R \_\_\_\_\_  
 T \_\_\_\_\_ R \_\_\_\_\_

2. Property Controlling S \_\_\_\_\_ T \_\_\_\_\_ R \_\_\_\_\_  
 in Section S \_\_\_\_\_ T \_\_\_\_\_ R \_\_\_\_\_

3. Miscellaneous S \_\_\_\_\_ T \_\_\_\_\_  
 Property in Sec. S \_\_\_\_\_ T \_\_\_\_\_

4. Lot No. \_\_\_\_\_, Recorded Plat \_\_\_\_\_

5. Private Claims \_\_\_\_\_

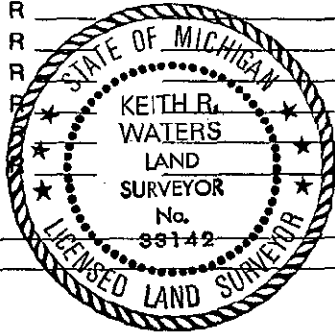

\$ 7.00 LAND CORNER  
 \$ 2.00 MSSR  
 19 JAN 95 4:13 P.M. RECEIPT# 2266  
 RECEIVED FOR RECORD  
 CHIPPEWA COUNTY - STATE OF MICHIGAN  
 SHARON H. KENNEDY, REGISTER OF DEEDS  
**Register of Deeds Stamp & File Number**

	A	B	C	D	E	F	G	H	I	J	K	L	M
2	6		5		4		3		2		1		
3													
4	7		8		9		10		11		12		
5													
6	18		17		16		15		14		13		
7													
8	19		20		21		22		23		24		
9													
10	30		29		28		27		26		25		
11													
12	31		32		33		34		35		36		
13													

Keith R. Waters in a field survey on August 3, 1994  
 do hereby certify that under requirements of P.A. 74, Michigan P.A. of 1970, the corner points mentioned in lines 1 and 2 above were in conformance with regulations and rules therefore as required in the current manual of survey instructions of the United States Department of the Interior, Bureau of Land Management or by a decree of a Court of Law and/or that the corner points mentioned in lines 3, 4 and 5 above were in conformance with the rules of the Michigan Board of Land Surveyors or by a Decree of a Court of Law; established, re-established, monumented, re-monumented, recovered, found as expressed below:

**NOTE: Not more than 4 corners, all in the same town and range, may be recorded on this certificate.**


**A. Description of original monument and accessories and/or subsequent restoration:**

D-11 1/4 Corner Common to Sections 29 & 32, T45N, R1W.

Original ties to post: Hemlock 15, N07°W 19 links Maple 10, S13°E 23 links.  
 1961 - Highway plans show corner 2 feet north of centerline of Tone Road.  
 1978 - Liber 1, page 355, Thomas Kelly, RLS 24599. Set 1/2" iron mid-way on line between section corners east and west.  
 1994 - Liber 8, page 287, Gary Koepke, P.S. 26458. Found 1/2" iron in a monument box in location as shown in liber 1, page 355.

**B. Description of corner evidence found and/or method applied in restoring or reestablishing corner:**

D-11 (T45N, R1W)  
 This corner is being perpetuated as part of the Chippewa County Remonumentation Program.  
 Found a 1/2" iron in a monument box on the south side of Tone Road as called for in liber 8, page 287. Offset iron with witness hubs prior to Tone Road re-construction. Monument box is to be placed in spring, 1995.

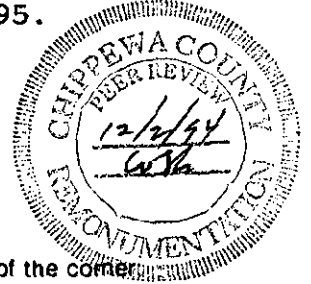

**C. Description of monument for corner and accessories established to perpetuate locating the position of the corner:**

D-11 (T45N, R1W)  
 Corner is a 3/4" x 24" rebar with a plastic Chippewa County Remonumentation cap in a monument box on the south side of Tone Road (M-80) to be placed in spring, 1995. Witnesses:  
 MDOT Tag in 14" Red Pine, N20°E 122.01'  
 MDOT Tag in 10" Jack Pine, N05°E 108.18'  
 MDOT Tag in Power Pole (104), N50°W 108.72'  
 Hydrant (Top Nut), S05°E 76.26'  
 Note: Bearings are based on MDOT records.

Signed by Keith R. Waters Date 12-23-94

Surveyor's Michigan License No. 33142