

SURVEY & REMONUMENTATION

APR 26 1995

CHIPPEWA COUNTY REMONUMENTATION CORNER

COMMISSION

LAND CORNER RECORDATION CERTIFICATE

Filing Requirement of Act 74, Mich. P.A. 1970

For corners in

Chippewa (County)	Located In:	Corner Code #
1. Public Land Survey	T <u>45N</u> R <u>1W</u>	<u>E-1</u>
	T _____ R _____	_____
	T _____ R _____	_____
	T _____ R _____	_____
2. Property Controlling in Section	S _____ T _____ R _____	_____
	S _____ T _____ R _____	_____
3. Miscellaneous Property in Sec.	S _____ T _____ R _____	_____
	S _____ T _____ R _____	_____

\$ 7.00 LAND CORNER
 \$ 2.00 MSSR
 5 DEC 94 12:26 P.M. RECEIPT# 1518
 RECEIVED FOR RECORD
 CHIPPEWA COUNTY - STATE OF MICHIGAN
 SHARON H. KENNEDY, REGISTER OF DEEDS

Register of Deeds Stamp & File Number

4. Lot No. _____, Recorded Plat _____
 5. Private Claims _____

	A	B	C	D	E	F	G	H	I	J	K	L	M
2	6		5		4		3		2		1		
3													
4	7		8		9		10		11		12		
5													
6	18		17		16		15		14		13		
7													
8	19		20		21		22		23		24		
9													
10	30		29		28		27		26		25		
11													
12	31		32		33		34		35		36		
13													

I, William L. Karr, in a field survey on October 28, 19 94, do hereby certify that under requirements of P.A. 74, Michigan P.A. of 1970, the corner points mentioned in lines 1 and 2 above were in conformance with regulations and rules therefore as required in the current manual of survey instructions of the United States Department of the Interior, Bureau of Land Management or by a decree of a Court of Law and/or that the corner points mentioned in lines 3, 4 and 5 above were in conformance with the rules of the Michigan Board of Land Surveyors or by a Decree of a Court of Law, established, re-established, monumented, re-monumented, recovered, found as expressed below:


NOTE: Not more than 4 corners, all in the same town and range, may be recorded on this certificate.

A. Description of original monument and accessories and/or subsequent restoration:

(E-1) Closing Corner Sections 5/4, T.45 N., R.1 W.

1845: Mullet intersected North boundary 30 lks East of post and set post corner to Sections 4 & 5. Birch 10 S87W 06
 Cedar 10 S78W 18

1977: J.H. Granger found a 4" diameter concrete monument and recorded the corner in L.1, P.250 of corner records.

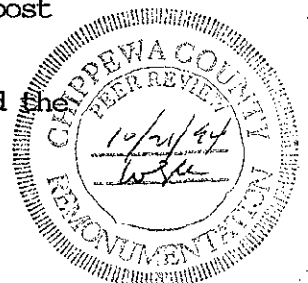

B. Description of corner evidence found and/or method applied in restoring or reestablishing corner:


(E-1) This corner is being perpetuated as part of the Chippewa County Remonumentation program.

Found no evidence of original corner.. Found the 4" diameter concrete monument as recorded by J.H.Granger. This monument works well as Standard Corner 32/33. I accepted the monument as Standard Corner 32/33 and re-established Closing Corner 5/4 19.80' to the East (GLO is 19.80')

C. Description of monument for corner and accessories established to perpetuate locating the position of the corner:

(E-1) Corner is a 3/4"x 24" iron with plastic "Chippewa County Remonumentation" cap and falls approximately 2' North of the centerline of 12 Mile Road (Gravel) and 183' West of the centerline of the R.R. tracks.

Witnesses: Power Pole	S20°E	45.67'
P.Pole(DR4/39E5/7)	S71°E	159.47'
Power Pole	N14°E	88.17'
S.W. Corner(steel) fencepost	N29°E	36.39'
Standard Corner 32/33	West	19.80'

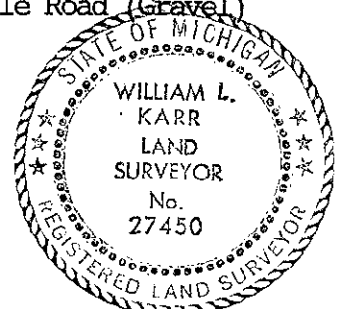

Signed by William L. Karr Date 12/2/94

Surveyor's Michigan License No. 27450

NOTE: Bearings are compass bearings corrected for declination.
 Distances are to a nail in side of witness objects unless noted.