

SURVEY & REMONUMENTATION

CHIPPEWA COUNTY REMONUMENTATION CORNER

APR 26 1995

LAND CORNER RECORDATION CERTIFICATE
Filing Requirement of Act 74, Mich. P.A. 1970


COMMISSION

For corners in
Chippewa

(County)

Located In: Corner Code #

- | | | | | | |
|---------------------------------------|---|-----|---|----|-----|
| 1. Public Land Survey | T | 45N | R | 1W | E-7 |
| | T | | R | | |
| | T | | R | | |
| | T | | R | | |
| 2. Property Controlling in Section | S | | T | R | |
| | S | | T | R | |
| 3. Miscellaneous Property in Sec. | S | | T | R | |
| | S | | T | R | |
| 4. Lot No. _____, Recorded Plat _____ | | | | | |
| 5. Private Claims _____ | | | | | |

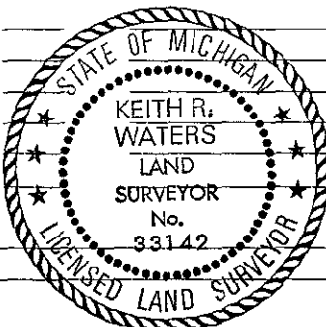

\$ 7.00 LAND CORNER
 \$ 2.00 HSSR
 5 DEC 94 12:35 P.M. RECEIPT# 1520
 RECEIVED FOR RECORD
 CHIPPEWA COUNTY - STATE OF MICHIGAN
 SHARON H. KENNEDY, REGISTER OF DEEDS

Register of Deeds Stamp & File Number

A	B	C	D	E	F	G	H	I	J	K	L	M
2	6	5	4	3	2	1						
3												
4	7	8	9	10	11	12						
5												
6	18	17	16	15	14	13						
7												
8	19	20	21	22	23	24						
9												
10	30	29	28	27	26	25						
11												
12	31	32	33	34	35	36						
13												

Keith R. Waters September 30 1994

I, Keith R. Waters, in a field survey on September 30, 1994, do hereby certify that under requirements of P.A. 74, Michigan P.A. of 1970, the corner points mentioned in lines 1 and 2 above were in conformance with regulations and rules therefore as required in the current manual of survey instructions of the United States Department of the Interior, Bureau of Land Management or by a decree of a Court of Law and/or that the corner points mentioned in lines 3, 4 and 5 above were in conformance with the rules of the Michigan Board of Land Surveyors or by a Decree of a Court of Law, established, re-established, monumented, re-monumented, recovered, found as expressed below:

NOTE: Not more than 4 corners, all in the same town and range, may be recorded on this certificate.

A. Description of original monument and accessories and/or subsequent restoration:

E-7 Corner Common to Sections 16, 17, 20, & 21, T45N, R1W.

Original ties to post: Birch 20, N72°E 42 links - Hemlock 16, S68°W 25 links. 1960 - (Highway Dept.), as recorded in liber 3, page 230, Chippewa County corner records. Found 1 1/4" galvanized pipe and 4" square wood post. 1978 - T. Kelly, R.L.S. 24599, as recorded in liber 1, page 359. Replaced pipe with 4" dia. conc. monument. Witnesses: 8" Birch, N22°E 54.40'-6" Spruce, N55°E 63.50'-4" Spruce, S65°E 23.40'-12" Maple, S36°W 8.48'

B. Description of corner evidence found and/or method applied in restoring or reestablishing corner:

E-7 (T45N, R1W)
 This corner is being perpetuated as part of the Chippewa County Remonumentation Program. Found a 4" diameter concrete monument as called for in 1978 recording. Also found maple bearing tree and stumps from birch and one spruce bearing trees. Other spruce is gone. Corner falls approximately 75 feet north of an east-west 2-track road. Accepted corner as found and established new witness objects.

C. Description of monument for corner and accessories established to perpetuate locating the position of the corner:

E-7 (T45N, R1W)
 Corner is a 4" diameter concrete monument with a 1/2" iron and plastic cap R.L.S. 24599, 75 feet north of an east-west 2-track road. Witnesses:

- 8" Red Maple, S32°W 8.56'
- 10" Red Maple, S82°W 15.40'
- 5" White Birch, N36°W 23.77'
- 9" Red Maple, S55°E 24.85'

Note: Distances are to a nail and tag in the side of the tree. Trees are blazed and painted. Bearings are compass bearings corrected for declination.

Signed by Keith R. Waters

Date 12-1-94

Surveyor's Michigan License No. 33142

