

**SURVEY &  
REMONUMENTATION**

**CHIPPEWA COUNTY REMONUMENTATION CORNER**

APR 26 1995

**LAND CORNER RECORDATION CERTIFICATE  
Filing Requirement of Act 74, Mich. P.A. 1970**

For corners in **COMMISSION**

Chippewa

(County)

Located In:

Corner Code E-8

1. Public Land Survey

T 45N R 1W

T \_\_\_\_\_ R \_\_\_\_\_

T \_\_\_\_\_ R \_\_\_\_\_

T \_\_\_\_\_ R \_\_\_\_\_

2. Property Controlling  
in Section

S \_\_\_\_\_ T \_\_\_\_\_ R \_\_\_\_\_

S \_\_\_\_\_ T \_\_\_\_\_ R \_\_\_\_\_


3. Miscellaneous  
Property in Sec.

S \_\_\_\_\_ T \_\_\_\_\_ R \_\_\_\_\_

S \_\_\_\_\_ T \_\_\_\_\_ R \_\_\_\_\_

4. Lot No. \_\_\_\_\_, Recorded Plat \_\_\_\_\_

5. Private Claims \_\_\_\_\_

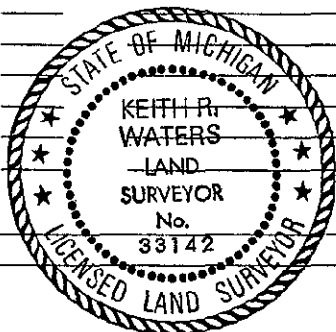

\$ 7.00 LAND CORNER  
\$ 2.00 MSSR  
19 JAN 95 4:13 P.M. RECEIPT# 2266  
RECEIVED FOR RECORD  
CHIPPEWA COUNTY - STATE OF MICHIGAN  
SHARON M. KENNEDY, REGISTER OF DEEDS

Register of Deeds Stamp & File Number

	A	B	C	D	E	F	G	H	I	J	K	L	M
2	6		5		4		3		2		1		
3													
4	7		8		9		10		11		12		
5													
6	18		17		16		15		14		13		
7													
8	19		20		21		22		23		24		
9													
10	30		29		28		27		26		25		
11													
12	31		32		33		34		35		36		
13													

I, Keith R. Waters in a field survey on December 1, 1994, do hereby certify that under requirements of P.A. 74, Michigan P.A. of 1970, the corner points mentioned in lines 1 and 2 above were in conformance with regulations and rules therefore as required in the current manual of survey instructions of the United States Department of the Interior, Bureau of Land Management or by a decree of a Court of Law and/or that the corner points mentioned in lines 3, 4 and 5 above were in conformance with the rules of the Michigan Board of Land Surveyors or by a Decree of a Court of Law; established, re-established, monumented, re-monumented, recovered, found as expressed below:

**NOTE: Not more than 4 corners, all in the same town and range, may be recorded on this certificate.**

A. Description of original monument and accessories and/or subsequent restoration:

E-8 1/4 Corner Common to Sections 20 & 21, T45N, R1W.

Original ties to post: Birch 20, S72°E 14 links Birch 16, S88°W 32 links. 1978 - As recorded in liber 1, page 359, Chippewa County corner records, by Thomas Kelly, RLS 24599. Set concrete monument by single proportionate measurement using section corners 2635.83 feet north and south. Witnesses: 6" Pine, N27°E 22.92' 6" Pine, SOUTH 8.70' S82°W 31.35'

B. Description of corner evidence found and/or method applied in restoring or reestablishing corner:

E-8 (T45N, R1W)

This corner is being perpetuated as part of the Chippewa County Remonumentation Program.

Found a 4" diameter concrete monument with 1/2" iron and plastic cap #24599 south of Gaines Highway. Also found two of the bearing trees as shown in liber 1, page 359. Accepted corner as found.

C. Description of monument for corner and accessories established to perpetuate locating the position of the corner:

E-8 (T45N, R1W)

Corner is a 4" diameter concrete monument with a 1/2" iron and cap #24599 approximately 290 feet south of the centerline of Gaines Highway. Witnesses:

- 10" Red Pine, N45°E 22.72'
- 7" Red Pine, N37°W 39.66'
- 10" Red Pine, S89°W 31.31'
- 8" Red Pine, S17°W 28.78'

Note: Distances are to a nail and tag in the side of the tree. Trees are blazed and painted. Bearings are compass bearings corrected for declination.



Signed by Keith R. Waters

Date 12-23-94

Surveyor's Michigan License No. 33142