

APR 26 1995


CHIPPEWA COUNTY REMONUMENTATION CORNER

COMMISSION

LAND CORNER RECORDATION CERTIFICATE
Filing Requirement of Act 74, Mich. P.A. 1970

For corners in Chippewa

(County)	Located In:	Corner Code #
1. Public Land Survey	T 45N R 1W	E-11
	T _____ R _____	
	T _____ R _____	
	T _____ R _____	
2. Property Controlling in Section	S _____ T _____ R _____	
	S _____ T _____ R _____	
3. Miscellaneous Property in Sec.	S _____ T _____ R _____	
	S _____ T _____ R _____	
4. Lot No. _____, Recorded Plat _____		
5. Private Claims _____		

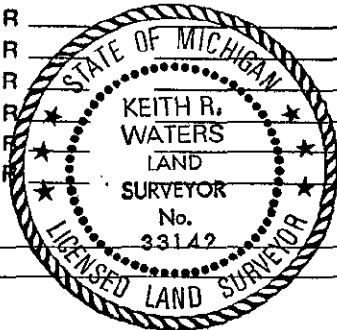

\$ 7.00 LAND CORNER
\$ 2.00 HSSR
19 JAN 95 4:14 P.M. RECEIPT# 2266
RECEIVED FOR RECORD
CHIPPEWA COUNTY - STATE OF MICHIGAN
SHARON H. KENNEDY, REGISTER OF DEEDS

Register of Deeds Stamp & File Number

	A	B	C	D	E	F	G	H	I	J	K	L	M
2	6	5	4	3	2	1							
3													
4	7	8	9	10	11	12							
5													
6	18	17	16	15	14	13							
7													
8	19	20	21	22	23	24							
9													
10	30	29	28	27	26	25							
11													
12	31	32	33	34	35	36							
13													

I, Keith R. Waters, in a field survey on August 3, 1994, do hereby certify that under requirements of P.A. 74, Michigan P.A. of 1970, the corner points mentioned in lines 1 and 2 above were in conformance with regulations and rules therefore as required in the current manual of survey instructions of the United States Department of the Interior, Bureau of Land Management or by a decree of a Court of Law and/or that the corner points mentioned in lines 3, 4 and 5 above were in conformance with the rules of the Michigan Board of Land Surveyors or by a Decree of a Court of Law; established, re-established, monumented, re-monumented, recovered, found as expressed below:

NOTE: Not more than 4 corners, all in the same town and range, may be recorded on this certificate.

A. Description of original monument and accessories and/or subsequent restoration:

E-11 Corner Common to Sections 28, 29, 32, & 33, T45N, R1W.
Original ties to post: Hemlock 10, N24°E 19 links Hemlock 15, S33°W 21 links MDOT right-of-way plans show corner 12.8 feet south of centerline of Tone Rd. 1978 - As recorded in liber 1, page 357, Chippewa County corner records, by Thomas Kelly, RLS 24599. Set corner using Highway stationing and also corners 1/2 mile north and 1/2 mile south. 1994 - As recorded in liber 8, page 288, by Gary Koepke, P.S. 26458, found 1/2" iron in monument box in position as shown in liber 1, page 357.

B. Description of corner evidence found and/or method applied in restoring or reestablishing corner:

E-11 (T45N, R1W)
This corner is being perpetuated as part of the Chippewa County Remonumentation Program.
Found 1/2" iron in a monument box on the south side of Tone Road (M-80) as called for in liber 8, page 288. Offset iron with witness hubs prior to Tone Road reconstruction. Monument box is to be placed in spring, 1995.



C. Description of monument for corner and accessories established to perpetuate locating the position of the corner:

E-11 (T45N, R1W)
Corner is a 3/4" rebar with a plastic Chippewa County Remonumentation cap in a monument box to be placed in spring, 1995. Witnesses:

- PK Nail in Power Pole, N30°W 66.58'
- PK Nail in Power Pole, S08°E 121.29'
- MDOT Tag in 8" Jack Pine, S85°W 81.51'
- MDOT Tag in 11" Aspen, N25°E 51.09'

Note: Bearings are based on MDOT records.

Signed by Keith R. Waters Date 12-23-94

Surveyor's Michigan License No. 33142