

APR 26 1995

LAND CORNER RECORDATION CERTIFICATE
Filing Requirement of Act 74, Mich. P.A. 1970

COMMISSION
For corners in
Chippewa

Located In: _____ Corner Code *EH*


1. Public Land Survey T 45N R 1W E-12
T _____ R _____
T _____ R _____
T _____ R _____

2. Property Controlling S _____ T _____ R _____
in Section S _____ T _____ R _____

3. Miscellaneous S _____ T _____ R _____
Property in Sec. S _____ T _____ R _____

4. Lot No. _____, Recorded Plat _____

5. Private Claims _____

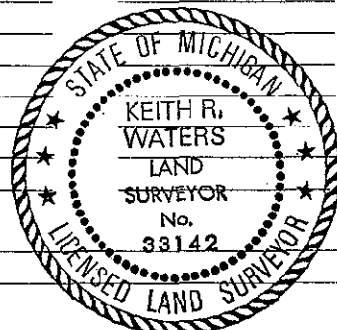

\$ 7.00 LAND CORNER
\$ 2.00 MSSR
5 DEC 94 12:34 P.M. RECEIPT# 1520
RECEIVED FOR RECORD
CHIPPEWA COUNTY - STATE OF MICHIGAN
SHARON H. KENNEDY, REGISTER OF DEEDS
Register of Deeds Stamp & File Number

	A	B	C	D	E	F	G	H	I	J	K	L	M
2	6	5	4	3	2	1							
3													
4	7	8	9	10	11	12							
5													
6	18	17	16	15	14	13							
7													
8	19	20	21	22	23	24							
9													
10	30	29	28	27	26	25							
11													
12	31	32	33	34	35	36							
13													

I, Keith R. Waters in a field survey on September 30, 1994, do hereby certify that under requirements of P.A. 74, Michigan P.A. of 1970, the corner points mentioned in lines 1 and 2 above were in conformance with regulations and rules therefore as required in the current manual of survey instructions of the United States Department of the Interior, Bureau of Land Management or by a decree of a Court of Law and/or that the corner points mentioned in lines 3, 4 and 5 above were in conformance with the rules of the Michigan Board of Land Surveyors or by a Decree of a Court of Law; established, re-established, monumented, re-monumented, recovered, found as expressed below:

NOTE: Not more than 4 corners, all in the same town and range, may be recorded on this certificate.

A. Description of original monument and accessories and/or subsequent restoration:

E-12 1/4 Corner Common to Sections 32 & 33, T45N, R1W

Original ties to post: 12" Sugar, N43°E 07 links
12" Spruce, S54°W 12 links
1978 - As recorded in liber 1, page 357, Chippewa County corner records, by Thomas Kelly, R.L.S. 24599. Set concrete monument by single proportionate measurement between section corners north and south. Witnesses: 4" Jack Pine, S16°E 16.57', 8" Pine, S48°W 22.11', 9" Pine, N36°E 22.98'.

B. Description of corner evidence found and/or method applied in restoring or reestablishing corner:

E-12 (T45N, R1W)
This corner is being perpetuated as part of the Chippewa County Remonumentation Program.
Found a 4" diameter concrete monument with 1/2" iron and plastic cap approximately 100 feet south of an east-west dirt road, approximately 15 feet east of the extension of a dirt road to the north. Also found all three bearing trees as shown in liber 1, page 357. (Tree called out as a 4" Jack Pine is actually a Red Pine). Thomas Kelly indicates that corner was established by single proportionate measurement between section corners north and south. Field measurements for previous surveys in the area verify this location. Accepted corner as found and established new bearing tree.

C. Description of monument for corner and accessories established to perpetuate locating the position of the corner:

E-12 (T45N, R1W)
Corner is a 4" diameter concrete monument with a 1/2" iron and plastic cap approximately 100 feet south and 15 feet east of the intersection of dirt roads east, west, and north, at the west edge of a red pine plantation.
Witnesses:

- 15" Red Pine, S48°W 22.11'
- 9" Red Pine, N36°E 22.98'
- 9" Red Pine, N74°E 10.76'
- 9" Red Pine, S16°E 16.57'

Note: Distances are to a nail and tag in the side of the witness object. Trees are blazed and painted. Bearings are compass bearings corrected for declination.

Signed by Keith R. Waters
Surveyor's Michigan License No. 33142

Date 12-1-94

