

SURVEY & REMONUMENTATION

CHIPPEWA COUNTY REMONUMENTATION CORNER

APR 26 1995

LAND CORNER RECORDATION CERTIFICATE
Filing Requirement of Act 74, Mich. P.A. 1970

For corners in **CHIPPEWA** COMMISSION

Located In: _____ Corner Code #/ # _____

(County) _____

1. Public Land Survey T 45N R 1W F-7

T _____ R _____

T _____ R _____

T _____ R _____

2. Property Controlling S _____ T _____ R _____


in Section S _____ T _____ R _____

3. Miscellaneous S _____ T _____ R _____

Property in Sec. S _____ T _____ R _____

4. Lot No. _____, Recorded Plat _____

5. Private Claims _____

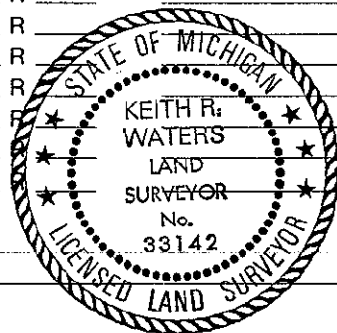

\$ 7.00 LAND CORNER
 \$ 2.00 MSSR
 5 DEC 94 12:34 P.M. RECEIPT# 1520
 RECEIVED FOR RECORD
 CHIPPEWA COUNTY - STATE OF MICHIGAN
 SHARON H. KENNEDY, REGISTER OF DEEDS

Register of Deeds Stamp & File Number

	A	B	C	D	E	F	G	H	I	J	K	L	M
2	6	5	4	3	2	1							
3													
4	7	8	9	10	11	12							
5													
6	18	17	16	15	14	13							
7													
8	19	20	21	22	23	24							
9													
10	30	29	28	27	26	25							
11													
12	31	32	33	34	35	36							
13													

Keith R. Waters July 13 1994

I, _____, in a field survey on _____, 19____, do hereby certify that under requirements of P.A. 74, Michigan P.A. of 1970, the corner points mentioned in lines 1 and 2 above were in conformance with regulations and rules therefore as required in the current manual of survey instructions of the United States Department of the Interior, Bureau of Land Management or by a decree of a Court of Law and/or that the corner points mentioned in lines 3, 4 and 5 above were in conformance with the rules of the Michigan Board of Land Surveyors or by a Decree of a Court of Law; established, re-established, monumented, re-monumented, recovered, found as expressed below:

NOTE: Not more than 4 corners, all in the same town and range, may be recorded on this certificate.

A. Description of original monument and accessories and/or subsequent restoration:

F-7 1/4 Corner Common to Sections 16 & 21, T45N, R1W

Original ties to post: Cedar 10, S17°E 18 links
 Cedar 8, N09°W 10 links

Found no evidence of subsequent restoration of corner.
 Original notes indicate corner was established between section corners 2637.36 feet east and 2637.36 feet west.

B. Description of corner evidence found and/or method applied in restoring or reestablishing corner:

F-7 (T45N, R1W)

This corner is being re-established as part of the Chippewa County Remonumentation Program.

Found no evidence of corner or its accessories. Re-established corner by single proportionate measurement on line between Section corners 2701.76 feet east and 2701.76 feet west. Corner falls approximately 40 feet north of an east-west trail.

C. Description of monument for corner and accessories established to perpetuate locating the position of the corner:

F-7 (T45N, R1W)

Corner is a 3/4" rebar with 3 1/4" aluminum Chippewa County Remonumentation cap 40 feet north of an east-west trail. Witnesses:

- 8" Spruce, N84°E 71.33'
- 6" Tamarack, S45°E 52.88'
- 3" Spruce, S09°E 82.39'
- 4" White Birch, S32°W 53.53'

Note: Distances are to a nail and tag in the side of the tree. Trees are blazed and painted. Bearings are compass bearings corrected for declination.

Signed by Keith R. Waters

Date 12-1-94

Surveyor's Michigan License No. 33142

