

SURVEY & REMONUMENTATION

APR 26 1995

CHIPPEWA COUNTY REMONUMENTATION CORNER

COMMISSION

LAND CORNER RECORDATION CERTIFICATE

Filing Requirement of Act 74, Mich. P.A. 1970

For corners in


Chippewa

(County)

Located In:

Corner Code #

- 1. Public Land Survey T 45N R 1W F-11
- T _____ R _____
- T _____ R _____
- T _____ R _____
- 2. Property Controlling S _____ T _____ R _____
- in Section S _____ T _____ R _____
- 3. Miscellaneous S _____ T _____ R _____
- Property in Sec. S _____ T _____ R _____
- 4. Lot No. _____, Recorded Plat _____
- 5. Private Claims _____

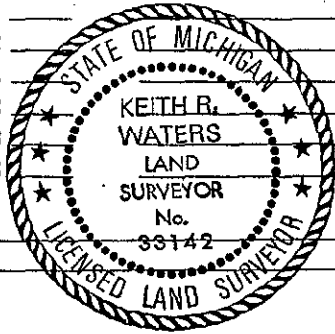

\$ 7.00 LAND CORNER
 \$ 2.00 MSSR
 19 JAN 95 4:15 P.M. RECEIPT# 2266
 RECEIVED FOR RECORD
 CHIPPEWA COUNTY - STATE OF MICHIGAN
 SHARON H. KENNEDY, REGISTER OF DEEDS

Register of Deeds Stamp & File Number

	A	B	C	D	E	F	G	H	I	J	K	L	M
2	6	5	4	3	2	1							
3													
4	7	8	9	10	11	12							
5													
6	18	17	16	15	14	13							
7													
8	19	20	21	22	23	24							
9													
10	30	29	28	27	26	25							
11													
12	31	32	33	34	35	36							
13													

I, Keith R. Waters in a field survey on August 3, 1994, do hereby certify that under requirements of P.A. 74, Michigan P.A. of 1970, the corner points mentioned in lines 1 and 2 above were in conformance with regulations and rules therefore as required in the current manual of survey instructions of the United States Department of the Interior, Bureau of Land Management or by a decree of a Court of Law and/or that the corner points mentioned in lines 3, 4 and 5 above were in conformance with the rules of the Michigan Board of Land Surveyors or by a Decree of a Court of Law; established, re-established, monumented, re-monumented, recovered, found as expressed below:

NOTE: Not more than 4 corners, all in the same town and range, may be recorded on this certificate.

A. Description of original monument and accessories and/or subsequent restoration:

F-11 1/4 Corner Common to Sections 28 & 33, T45N, R1W.

Original ties to post: Fir 10, N19°E 20 links Fir 12, S01°W 25 links.
 1960 - Highway Department, liber 2, page 230. Found 1/2" iron under asphalt.
 1978 - Liber 1, page 355, Thomas Kelly, RLS 24599, Set 1/2" iron.
 1994 - Liber 8, page 290, Gary Koepke, P.S. 26458. Found 1/2" iron with cap #27447 in a monument box, set by Neil Hill, P.S. 27447, using record position as shown in 1961 Highway plans.

B. Description of corner evidence found and/or method applied in restoring or reestablishing corner:


F-11 (T45N, R1W)
 This corner is being perpetuated as part of the Chippewa County Remonumentation Program.
 Found a 1/2" iron with cap #27447 in a monument box 0.5 feet north of the centerline of Tone Road (M-80) as called for in liber 8, page 290. Offset iron with witness hubs prior to Tone Road re-construction. Monument box is to be placed in spring, 1995.

C. Description of monument for corner and accessories established to perpetuate locating the position of the corner:

F-11 (T45N, R1W)
 Corner is a 3/4" x 24" rebar with a plastic Chippewa County Remonumentation cap in a monument box to be placed in spring, 1995. Witnesses:

- MDOT Tag in 30" Oak, N30°E 54.27'
- Found "T" Iron, S04°W 32.22'
- Face of Concrete Project Marker, S05°W 31.77'
- MDOT Tag in 5" Pine, S60°E 74.57'

Note: Bearings are based on MDOT records.

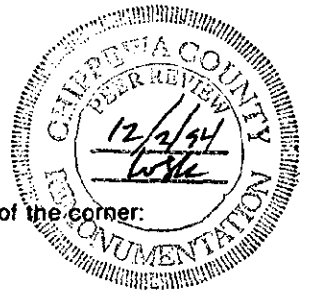

Signed by Keith R. Waters Date 12-23-94

Surveyor's Michigan License No. 33142