

**SURVEY & REMONUMENTATION**

CHIPPEWA COUNTY REMONUMENTATION CORNER

APR 26 1995

**LAND CORNER RECORDATION CERTIFICATE**  
Filing Requirement of Act 74, Mich. P.A. 1970

For corners of **CHIPPEWA** COMMISSION  
Chippewa

Located In: \_\_\_\_\_ Corner Code #/ \_\_\_\_\_

(County)

1. Public Land Survey T45N R1W F-13  
T \_\_\_\_\_ R \_\_\_\_\_  
T \_\_\_\_\_ R \_\_\_\_\_  
T \_\_\_\_\_ R \_\_\_\_\_


2. Property Controlling in Section S \_\_\_\_\_ T \_\_\_\_\_ R \_\_\_\_\_  
S \_\_\_\_\_ T \_\_\_\_\_ R \_\_\_\_\_

3. Miscellaneous Property in Sec. S \_\_\_\_\_ T \_\_\_\_\_ R \_\_\_\_\_  
S \_\_\_\_\_ T \_\_\_\_\_ R \_\_\_\_\_

4. Lot No. \_\_\_\_\_, Recorded Plat \_\_\_\_\_

5. Private Claims \_\_\_\_\_

\$ 7.00 LAND CORNER  
\$ 2.00 MSSR  
24 OCT 94 3:48 P.M. RECEIPT# 831  
RECEIVED FOR RECORD  
CHIPPEWA COUNTY - STATE OF MICHIGAN  
SHARON H. KENNEDY, REGISTER OF DEEDS  
**Register of Deeds Stamp & File Number**

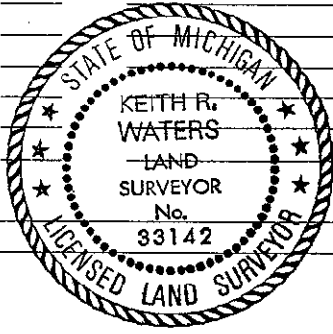

	A	B	C	D	E	F	G	H	I	J	K	L	M
2	6	5	4	3	2	1							
3													
4	7	8	9	10	11	12							
5													
6	18	17	16	15	14	13							
7													
8	19	20	21	22	23	24							
9													
10	30	29	28	27	26	25							
11													
12	31	32	33	34	35	36							
13													

I, Keith R. Waters, in a field survey on June 21, 1994, do hereby certify that under requirements of P.A. 74, Michigan P.A. of 1970, the corner points mentioned in lines 1 and 2 above were in conformance with regulations and rules therefore as required in the current manual of survey instructions of the United States Department of the Interior, Bureau of Land Management or by a decree of a Court of Law and/or that the corner points mentioned in lines 3, 4 and 5 above were in conformance with the rules of the Michigan Board of Land Surveyors or by a Decree of a Court of Law; established, re-established, monumented, re-monumented, recovered, found as expressed below:

**NOTE: Not more than 4 corners, all in the same town and range, may be recorded on this certificate.**

A. Description of original monument and accessories and/or subsequent restoration:

F-13 South 1/4 Corner of Section 33, T45N, R1W

Original ties to post: Y. Pine, N06°E 55 links (No diameter indicated)  
Fir 4, N81°W 10 links

1978 - Corner recorded in liber 1, page 355, Chippewa County corner records, T. Kelly, RLS 24599. Set concrete monument. Witnesses: 5" White Pine, S65°E 30.45' - 4" White Pine, S15°W 41.93' - 10 W. Birch, S72°W 78.20'

B. Description of corner evidence found and/or method applied in restoring or reestablishing corner:

F-13 (T45N, R1W)  
This corner is being perpetuated as part of the Chippewa County Remonumentation Program.  
Found a 4" diameter concrete monument and two bearing trees from previous recording. (BT called out as a 4" white pine is actually a red pine).  
Corner was established by single proportionate measurement on the township line between township corner to the west and common corner to Sections 3 & 4, T44N, R1W and Sections 33 & 34, T45N, R1W. Corner falls approximately 40 feet south of an east-west 2-track road. Accepted corner as found and established new witness objects.

C. Description of monument for corner and accessories established to perpetuate locating the position of the corner:

F-13 (T45N, R1W)  
Corner is 4" diameter concrete monument approximately 40 feet south of an east-west 2-track road. Witnesses:

7" Red Pine, S52°E 34.02'  
10" Red Pine, S11°W 41.78'  
14" White Birch, S66°W 78.03'  
10" White Pine, S87°W 46.72'

Note: Distances are to a nail and tag in the side of the witness object. Trees are blazed and painted. Bearings are compass bearings corrected for declination.

Signed by Keith R. Waters  
Surveyor's Michigan License No. 33142

Date 10-18-94

