

SURVEY & REMONUMENTATION

CHIPPEWA COUNTY REMONUMENTATION CORNER


APR 26 1995

LAND CORNER RECORDATION CERTIFICATE
 Filing Requirement of Act 74, Mich. P.A. 1970

For corners in **CHIPPEWA**
 (County)

Located In: Corner Code #

- | | | | | |
|---------------------------------------|---|--------------|-----------|------------|
| 1. Public Land Survey | T | <u>45N</u> R | <u>1W</u> | <u>G-9</u> |
| | T | ___ | R | ___ |
| | T | ___ | R | ___ |
| | T | ___ | R | ___ |
| 2. Property Controlling in Section | S | ___ | T | ___ |
| | S | ___ | T | ___ |
| 3. Miscellaneous Property in Sec. | S | ___ | T | ___ |
| | S | ___ | T | ___ |
| 4. Lot No. _____, Recorded Plat _____ | | | | |
| 5. Private Claims _____ | | | | |

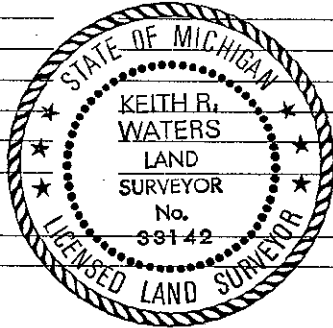

\$ 7.00 LAND CORNER
 \$ 2.00 MSSR
 5 DEC 94 12:34 P.M. RECEIPT# 1520
 RECEIVED FOR RECORD
 CHIPPEWA COUNTY - STATE OF MICHIGAN
 SHARON H. KENNEDY, REGISTER OF DEEDS
Register of Deeds Stamp & File Number

	A	B	C	D	E	F	G	H	I	J	K	L	M
2	6	5	4	3	2	1							
3													
4	7	8	9	10	11	12							
5													
6	18	17	16	15	14	13							
7													
8	19	20	21	22	23	24							
9													
10	30	29	28	27	26	25							
11													
12	31	32	33	34	35	36							
13													

I, Keith R. Waters in a field survey on September 30, 19 94, do hereby certify that under requirements of P.A. 74, Michigan P.A. of 1970, the corner points mentioned in lines 1 and 2 above were in conformance with regulations and rules therefore as required in the current manual of survey instructions of the United States Department of the Interior, Bureau of Land Management or by a decree of a Court of Law and/or that the corner points mentioned in lines 3, 4 and 5 above were in conformance with the rules of the Michigan Board of Land Surveyors or by a Decree of a Court of Law; established, re-established, monumented, re-monumented, recovered, found as expressed below:

NOTE: Not more than 4 corners, all in the same town and range, may be recorded on this certificate.

A. Description of original monument and accessories and/or subsequent restoration:

G-9 Corner Common to Sections 21, 22, 27, & 28, T45N, R1W

Original ties to post: Fir 10, S61°W 25 links - Birch 10, N45°E 46 links. 1958 - As recorded in liber 3, page 28, Chippewa County corner records, by Billy Buckler. Set 1" pipe and DNR cap as perpetuation of existing corner. 1978 - As recorded in liber 1, page 354, Chippewa County corner records by Tom Kelly. Found DNR monument and all existing BT's. Witnesses: 28" Oak, S18°W 106.59', 26" Oak, N64°E 60.92', 28" Oak, N26°E 102.96'.

B. Description of corner evidence found and/or method applied in restoring or reestablishing corner:

G-9 (T45N, R1W)

This corner is being perpetuated as part of the Chippewa County Remonumentation Program.

Found a 1" iron pipe with a DNR cap approximately 19 feet north of an east-west 2-track road. Existing BT shown in liber 1, page 354, as 28" Oak, N26°E 102.96' is actually a maple and is now dead. Found other two existing BT's alive, but in very poor shape. Buckler's corner form indicates that this position is a perpetuation of an existing corner by an unknown surveyor, records of which were found in the Chippewa County Surveyor's office. Accepted corner as found and established four new bearing trees.

C. Description of monument for corner and accessories established to perpetuate locating the position of the corner:

G-9 (T45N, R1W)

Corner is a 1" pipe with 4" Brass DNR cap 19 feet north of an east-west 2-track road. Witnesses:

- 6" Red Maple, S84°W 4.53'
- 12" Sugar Maple, N35°W 11.57'
- 4" Red Oak, N38°E 20.72'
- 8" White Birch, N80°E 36.02'

Note: Distances are to a nail and tag in the side of the witness object. Trees are blazed and painted. Bearings are compass bearings corrected for declination.

Signed by Keith R. Waters

Date 12-1-94

Surveyor's Michigan License No. 33142

