

**SURVEY & REMONUMENTATION**

**CHIPPEWA COUNTY REMONUMENTATION CORNER**

APR 26 1995

**COMMISSION**


**LAND CORNER RECORDATION CERTIFICATE**

Filing Requirement of Act 74, Mich. P.A. 1970

For corners in Chippewa

Located In: Corner Code #

- |                                    |   |     |   |    |      |
|------------------------------------|---|-----|---|----|------|
| 1. Public Land Survey              | T | 45N | R | 1W | G-12 |
|                                    | T |     | R |    |      |
|                                    | T |     | R |    |      |
|                                    | T |     | R |    |      |
| 2. Property Controlling in Section | S |     | R |    |      |
|                                    | S |     | R |    |      |
| 3. Miscellaneous Property in Sec.  | S |     | T |    |      |
|                                    | S |     | T |    |      |
4. Lot No. \_\_\_\_\_, Recorded Plat \_\_\_\_\_
5. Private Claims \_\_\_\_\_

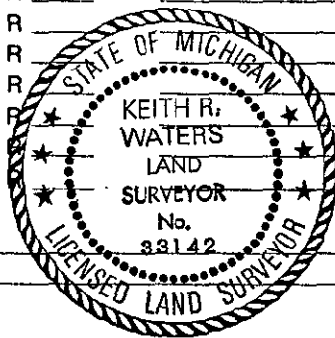

\$ 7.00 LAND CORNER  
 \$ 2.00 MSSR  
 19 JAN 95 4:16 P.M. RECEIPT# 2266  
 RECEIVED FOR RECORD  
 CHIPPEWA COUNTY - STATE OF MICHIGAN  
 SHARON H. KENNEDY, REGISTER OF DEEDS  
**Register of Deeds Stamp & File Number**

	A	B	C	D	E	F	G	H	I	J	K	L	M
2	6	5	4	3	2	1							
3													
4	7	8	9	10	11	12							
5													
6	18	17	16	15	14	13							
7													
8	19	20	21	22	23	24							
9													
10	30	29	28	27	26	25							
11													
12	31	32	33	34	35	36							
13													

**Keith R. Waters** November 22 1994

I, Keith R. Waters, in a field survey on November 22, 1994, do hereby certify that under requirements of P.A. 74, Michigan P.A. of 1970, the corner points mentioned in lines 1 and 2 above were in conformance with regulations and rules therefore as required in the current manual of survey instructions of the United States Department of the Interior, Bureau of Land Management or by a decree of a Court of Law and/or that the corner points mentioned in lines 3, 4 and 5 above were in conformance with the rules of the Michigan Board of Land Surveyors or by a Decree of a Court of Law; established, re-established, monumented, re-monumented, recovered, found as expressed below:

**NOTE: Not more than 4 corners, all in the same town and range, may be recorded on this certificate.**


**A. Description of original monument and accessories and/or subsequent restoration:**

G-12 1/4 Corner Common to Sections 33 & 34, T45N, R1W.

Original ties to post: Sugar 12, S73°W 14 links Birch 10, N78°E 45 links  
 1975 - Corner is shown on various surveys by Neree D. Alix, RLS 6254.  
 1978 - As recorded in liber 1, page 353, Chippewa County corner records, by Thomas Kelly, RLS 24599. Found 1/2" iron as shown in above mentioned surveys. Witnesses: 14" Maple, N28°E 85.38' Fence Post, EAST 176.35'  
 5" Pine, S42°E 68.64.

**B. Description of corner evidence found and/or method applied in restoring or reestablishing corner:**

G-12 (T45N, R1W)  
 This corner is being perpetuated as part of the Chippewa County Remonumentation Program.  
 Found a 1/2" iron on the east edge of a north-south gravel road. Also found three witness objects as shown in liber 1, page 353. Corner is 2641.04 feet from section corner to the south, 2676.50 feet from section corner to the north, and is 20.89 feet east of a straight line between said section corners. Distance to section corner north is very close to that as shown in Alix surveys. Distances to section corners north and south are also within approximately 1 foot of those as shown in old County Surveyor notes. Accepted corner location as found and replaced 1/2" iron with a 3/4" rebar and plastic Chippewa County Remonumentation cap.

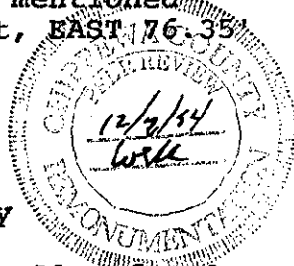

**C. Description of monument for corner and accessories established to perpetuate locating the position of the corner:**

G-12 (T45N, R1W)  
 Corner is a 3/4" x 24" rebar with a plastic Chippewa County Remonumentation cap on the east edge of gravel road (Wilson Road). Corner is 32 feet south of the south end of asphalt pavement on said Wilson Road. Witnesses:

- 12" Red Pine, S53°E 68.81'
- 12" Red Pine, S80°E 105.74'
- 12" Red Pine, S32°E 127.92'
- Twin 12" Sugar Maple, N20°E 85.34'

Note: Distances are to a nail and tag in side of tree. Trees are blazed (maple has small side blaze only at measuring nail. Bearings are compass bearings corrected for declination.

Signed by Keith R. Waters Date 12-23-94  
 Surveyor's Michigan License No. 33142