

SURVEY & REMONUMENTATION

CHIPPEWA COUNTY REMONUMENTATION CORNER

APR 26 1995

LAND CORNER RECORDATION CERTIFICATE

Filing Requirement of Act 74, Mich. P.A. 1970

For corners in **CHIPPEWA** COMMISSION

(County)	Located In:	Corner Code #
1. Public Land Survey	T <u>45N</u> R <u>1W</u>	<u>H-9</u>
	T _____ R _____	_____
	T _____ R _____	_____
	T _____ R _____	_____
2. Property Controlling in Section	S _____ T _____ R _____	_____
	S _____ T _____ R _____	_____
3. Miscellaneous Property in Sec.	S _____ T _____ R _____	_____
	S _____ T _____ R _____	_____
4. Lot No. _____, Recorded Plat _____		
5. Private Claims _____		

\$ 7.00 LAND CORNER
 \$ 2.00 MSSR
 19 JAN 95 4:16 P.M. RECEIPT# 2266
 RECEIVED FOR RECORD
 CHIPPEWA COUNTY - STATE OF MICHIGAN
 SHARON H. KENNEDY, REGISTER OF DEEDS

Register of Deeds Stamp & File Number

A	B	C	D	E	F	G	H	I	J	K	L	M
2	6	5	4	3	2	1						
3												
4	7	8	9	10	11	12						
5												
6	16	17	16	15	14	13						
7												
8	19	20	21	22	23	24						
9												
10	30	29	28	27	26	25						
11												
12	31	32	33	34	35	36						
13												

I, Keith R. Waters in a field survey on December 12, 1994 do hereby certify that under requirements of P.A. 74, Michigan P.A. of 1970, the corner points mentioned in lines 1 and 2 above were in conformance with regulations and rules therefore as required in the current manual of survey instructions of the United States Department of the Interior, Bureau of Land Management or by a decree of a Court of Law and/or that the corner points mentioned in lines 3, 4 and 5 above were in conformance with the rules of the Michigan Board of Land Surveyors or by a Decree of a Court of Law; established, re-established, monumented, re-monumented, recovered, found as expressed below:

NOTE: Not more than 4 corners, all in the same town and range, may be recorded on this certificate.

A. Description of original monument and accessories and/or subsequent restoration:

H-9 1/4 Corner Common to Sections 22 & 27, T45N, R1W.


Original ties to post: Hemlock 20, S45°W 25 links Birch 10, N25°E 26 links. 1978 - As recorded in liber 1, page 305, Chippewa County corner records, by Billy Buckler, RLS 8887. Set 1" pipe and 4" aluminum cap mid-way on line between section corners 2725.4 feet east and west. Length of overall mile checks very well with County Surveyor notes. Witnesses: 14" Hemlock, S88°E 15.8' 16" Hemlock, N41°E 32.35' 8" Hemlock, N60°W 42.2'

B. Description of corner evidence found and/or method applied in restoring or reestablishing corner:

H-9 (T45N, R1W)

This corner is being perpetuated as part of the Chippewa County Remonumentation Program.

Found a 1" iron pipe with a 4" aluminum DNR cap and all three bearing trees as called for in liber 1, page 305. Accepted corner as found and established an additional bearing tree.

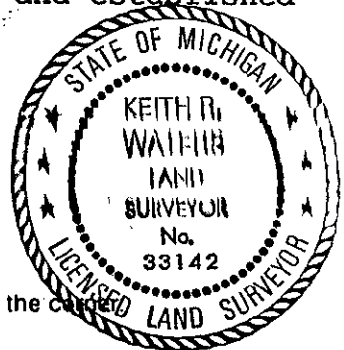

C. Description of monument for corner and accessories established to perpetuate locating the position of the corner:

H-9 (T45N, R1W)

Corner is 1" iron pipe with a 4" aluminum DNR cap. Witnesses:

- 19" Hemlock, S88°E 16.04'
- 23" Hemlock, N41°E 33.15'
- 12" Hemlock, N60°W 42.35'
- 13" Hemlock, S07°W 66.76'

Note: Distances are to a nail in the side of the tree. Trees are blazed and painted. Bearings are compass bearings corrected for declination.

Signed by Keith R. Waters

Date 12-23-04

12/16/04