

**SURVEY & REMONUMENTATION**

CHIPPEWA COUNTY REMONUMENTATION CORNER

APR 26 1995

LAND CORNER RECORDATION CERTIFICATE

Filing Requirement of Act 74, Mich. P.A. 1970

For corners **COMMISSION**

|                                    |                          |               |
|------------------------------------|--------------------------|---------------|
| <u>Chippewa</u><br>(County)        | Located In:              | Corner Code # |
| 1. Public Land Survey              | T <u>45N</u> R <u>1W</u> | <u>I-1</u>    |
|                                    | T _____ R _____          | _____         |
|                                    | T _____ R _____          | _____         |
|                                    | T _____ R _____          | _____         |
| 2. Property Controlling in Section | S _____ T _____ R _____  | _____         |
|                                    | S _____ T _____ R _____  | _____         |
| 3. Miscellaneous Property in Sec.  | S _____ T _____ R _____  | _____         |
|                                    | S _____ T _____ R _____  | _____         |

\$ 7.00 LAND CORNER  
 \$ 2.00 MSSR  
 5 DEC 94 12:27 P.M. RECEIPT# 1518  
 RECEIVED FOR RECORD  
 CHIPPEWA COUNTY - STATE OF MICHIGAN  
 SHARON H. KENNEDY, REGISTER OF DEEDS  
 Register of Deeds Stamp & File Number

4. Lot No. \_\_\_\_\_, Recorded Plat \_\_\_\_\_  
 5. Private Claims \_\_\_\_\_

|    |    |    |    |    |    |    |   |   |   |   |   |   |   |
|----|----|----|----|----|----|----|---|---|---|---|---|---|---|
|    | A  | B  | C  | D  | E  | F  | G | H | I | J | K | L | M |
| 2  | 6  | 5  | 4  | 3  | 2  | 1  |   |   |   |   |   |   |   |
| 3  |    |    |    |    |    |    |   |   |   |   |   |   |   |
| 4  | 7  | 8  | 9  | 10 | 11 | 12 |   |   |   |   |   |   |   |
| 5  |    |    |    |    |    |    |   |   |   |   |   |   |   |
| 6  | 18 | 17 | 16 | 15 | 14 | 13 |   |   |   |   |   |   |   |
| 7  |    |    |    |    |    |    |   |   |   |   |   |   |   |
| 8  | 19 | 20 | 21 | 22 | 23 | 24 |   |   |   |   |   |   |   |
| 9  |    |    |    |    |    |    |   |   |   |   |   |   |   |
| 10 | 30 | 29 | 28 | 27 | 26 | 25 |   |   |   |   |   |   |   |
| 11 |    |    |    |    |    |    |   |   |   |   |   |   |   |
| 12 | 31 | 32 | 33 | 34 | 35 | 36 |   |   |   |   |   |   |   |
| 13 |    |    |    |    |    |    |   |   |   |   |   |   |   |


I, William L. Karr, in a field survey on October 28, 1994, do hereby certify that under requirements of P.A. 74, Michigan P.A. of 1970, the corner points mentioned in lines 1 and 2 above were in conformance with regulations and rules therefore as required in the current manual of survey instructions of the United States Department of the Interior, Bureau of Land Management or by a decree of a Court of Law and/or that the corner points mentioned in lines 3, 4 and 5 above were in conformance with the rules of the Michigan Board of Land Surveyors or by a Decree of a Court of Law; established, re-established, monumented, re-monumented, recovered, found as expressed below.

**NOTE: Not more than 4 corners, all in the same town and range, may be recorded on this certificate.**

A. Description of original monument and accessories and/or subsequent restoration:

(I-1) Closing Corner Sections 3/2, T.45 N., R.1 W. (Not common)

- 1845: J. Mullett intersected N. Boundary 35 lks (23.10') East of post and set corner sections 2 & 3. Cedar 4 S51W 23 Birch 10 S18E 12
- 1901: County Surveyor notes show the North line of Section 2 as measuring 5268' (5270.26' today).

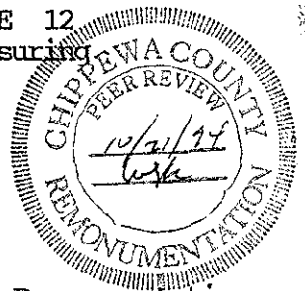

B. Description of corner evidence found and/or method applied in restoring or reestablishing corner:


(I-1) This corner is being perpetuated as part of the Chippewa County Remonumentation program.

Found no evidence of original corner. Found a 1/2" iron in concrete on extension of fenceline to the South. Road has been raised. Set a 1/2" iron with cap No. 27450 over the existing monument. Accepted corner position as found. Corner falls 23.10' East (GLO-23.10') of the re-established S.C. 34/35.

C. Description of monument for corner and accessories established to perpetuate locating the position of the corner:

(I-1) Corner is a 1/2" iron w/cap No.27450, 6' North of the centerline of 12 Mile Road. Corner falls on the extension of a fenceline to the South.

|  |              |
|--|--------------|
| Witnesses: 1"x 48" pipe w/cap No.27450 | N23°W 55.86' |
| 1"x 48" pipe w/metal cap               | N32°W 41.09' |
| 1"x 48" pipe w/metal cap               | South 33.14' |
| 1"x 48" pipe w/metal cap               | South 49.92' |
| Standard Corner 34/35                  | West 23.10'  |

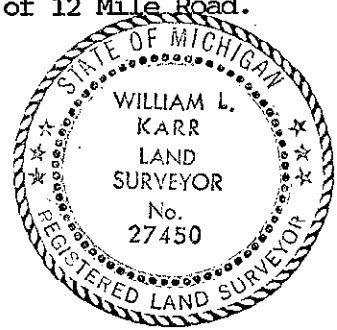

Signed by William L. Karr Date 12/2/94  
 Surveyor's Michigan License No. 27450

NOTE: Bearings are compass bearings corrected for declination.  
 Distances are to a nail in side of witness objects unless noted.