SURVEY & REMONUMENTATION

APR 2 6 1995

COMMISSION

CHIPPEWA COUNTY REMONUMENTATION CORNER

LAND CORNER RECORDATION CERTIFICATE

Filing Requirement of Act 74, Mich. P.A. 1970

For corners in Chippewa (County)

	Located In:	Corner Code ##
1. Public Land Survey	T 45N R 1W	I-7
	T ___ R ___	
	T ___ R ___	
	T ___ R ___	
2. Property Controlling	S ___ T ___ R ___	
in Section	S ___ T ___ R ___	
3. Miscellaneous	S ___ T ___ R ___	
Property in Sec.	S ___ T ___ R ___	

$ 7.00 LAND CORNER
$ 2.00 MSSR
24 OCT 94 3:48 P.M. RECEIPT# 831
RECEIVED FOR RECORD
CHIPPEWA COUNTY - STATE OF MICHIGAN
SHARON H. KENNEDY, REGISTER OF DEEDS

Register of Deeds Stamp & File Number

STATE OF MICHIGAN
KEITH R. WATERS
LAND SURVEYOR
No. 33142
LICENSED LAND SURVEYOR

4. Lot No. _____, Recorded Plat _____
5. Private Claims _____

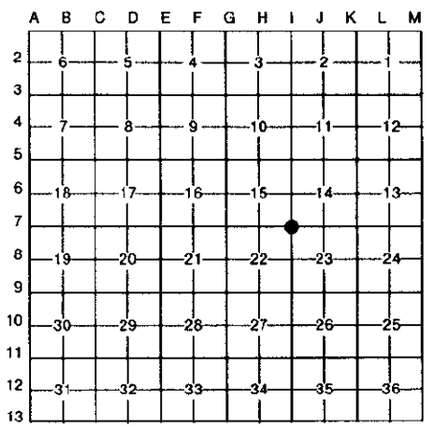

I, Keith R. Waters in a field survey on February 14, 19 94, do hereby certify that under requirements of P.A. 74, Michigan P.A. of 1970, the corner points mentioned in lines 1 and 2 above were in conformance with regulations and rules therefore as required in the current manual of survey instructions of the United States Department of the Interior, Bureau of Land Management or by a decree of a Court of Law and/or that the corner points mentioned in lines 3, 4 and 5 above were in conformance with the rules of the Michigan Board of Land Surveyors or by a Decree of a Court of Law; established, re-established, monumented, re-monumented, recovered, found as expressed below:

NOTE: Not more than 4 corners, all in the same town and range, may be recorded on this certificate.

A. Description of original monument and accessories and/or subsequent restoration:

I-7 Corner Common to Sections 14,15,22, & 23, T45N, R1W

Original ties to post: Birch 10, N39°W 18 links
Fir 8, S45°E 27 links
1959 - This corner is recorded in liber 3, page 26, Chippewa County corner records, by Billy Buckler, P.S. 8887, as a 1" pipe with 4" brass cap.
Record witnesses: 14" White Pine, N68°E 62 links - 10" Aspen, N77°W 19 links
5" Balsam, S03°E 54½ links
Corner is 75 links west and 75 links south of old RR grade.

B. Description of corner evidence found and/or method applied in restoring or reestablishing corner:

I-7 (T45N, R1W)
This corner is being perpetuated as part of the Chippewa County Remonumentation Program.
Found a 1" iron pipe with 4" brass cap stamped "Michigan Department of Conservation - Forestry Division" on southwest side of old railroad grade. Aspen and white pine bearings trees from previous recording are in bad shape, but still standing and check well. Buckler's corner form indicates that corner was established by double proportionate measurement from 1/4 corner ½ mile east, 1/4 corner ½ mile south, stream crossing 24.00 chains north, and County Surveyor notes from 1909 to old Mackinac Trail to the west. Accepted corner as found and established four new witness objects.

C. Description of monument for corner and accessories established to perpetuate locating the position of the corner:

I-7 (T45N, R1W)
Corner is a 1" pipe with 4" brass cap approximately 50 south and 50 feet west of an old northwesterly railroad grade. Witnesses:

5" Maple, S66°E 32.00'
8" Maple, N63°E 19.61'
10" Maple, N19°W 8.59'
10" Maple, S77°W 8.11'

Note: Distances are to a nail and tag in the side of the tree. Trees are blazed and painted. Bearings are compass bearings corrected for declination.

Signed by Keith R. Waters Date 10-18-94

Surveyor's Michigan License No. 33142

CHIPPEWA COUNTY REMONUMENTATION COMMISSION Accepted 10/27/94 [illegible]

FORM APPROVED BY MICHIGAN STATE BOARD OF LAND SURVEYORS, JAN. 28, 1971
REVISED MAY 14, 1975
REVISED JAN. 1983