

**SURVEY &  
REMONUMENTATION**

**CHIPPEWA COUNTY REMONUMENTATION CORNER**

APR 26 1995


**LAND CORNER RECORDATION CERTIFICATE**

Filing Requirement of Act 74, Mich. P.A. 1970

For corners in **CHIPPEWA**  
**Chippewa**  
(County)

Located In: Corner Code #

- |                                       |                           |            |
|---------------------------------------|---------------------------|------------|
| 1. Public Land Survey                 | T <u>45N</u> R <u>R1W</u> | <u>I-9</u> |
|                                       | T _____ R _____           | _____      |
|                                       | T _____ R _____           | _____      |
|                                       | T _____ R _____           | _____      |
| 2. Property Controlling in Section    | S _____ T _____ R _____   | _____      |
|                                       | S _____ T _____ R _____   | _____      |
| 3. Miscellaneous Property in Sec.     | S _____ T _____ R _____   | _____      |
|                                       | S _____ T _____ R _____   | _____      |
| 4. Lot No. _____, Recorded Plat _____ |                           |            |
| 5. Private Claims _____               |                           |            |

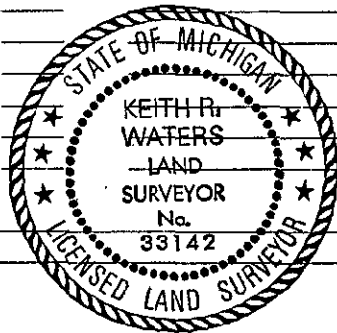

\$ 7.00 LAND CORNER  
\$ 2.00 MSSR  
19 JAN 95 4:16 P.M. RECEIPT# 2266  
RECEIVED FOR RECORD  
CHIPPEWA COUNTY - STATE OF MICHIGAN  
SHARON H. KENNEDY, REGISTER OF DEEDS

Register of Deeds Stamp & File Number

A	B	C	D	E	F	G	H	I	J	K	L	M
2	6	5	4	3	2	1						
3												
4	7	8	9	10	11	12						
5												
6	18	17	16	15	14	13						
7												
8	19	20	21	22	23	24						
9												
10	30	29	28	27	26	25						
11												
12	31	32	33	34	35	36						
13												

I, Keith R. Waters, in a field survey on October 31, 1994, do hereby certify that under requirements of P.A. 74, Michigan P.A. of 1970, the corner points mentioned in lines 1 and 2 above were in conformance with regulations and rules therefore as required in the current manual of survey instructions of the United States Department of the Interior, Bureau of Land Management or by a decree of a Court of Law and/or that the corner points mentioned in lines 3, 4 and 5 above were in conformance with the rules of the Michigan Board of Land Surveyors or by a Decree of a Court of Law; established, re-established, monumented, re-monumented, recovered, found as expressed below:

**NOTE: Not more than 4 corners, all in the same town and range, may be recorded on this certificate.**

A. Description of original monument and accessories and/or subsequent restoration:

I-9 Corner Common to Sections 22, 23, 26, & 27, T45N, R1W.

Original ties to post: Fir 8, N60°E 12 links Cedar 12, S47°W 10 links.  
1978 - As recorded in liber 1, page 300, Chippewa County corner records, by Billy Buckler, RLS 8887. Set 1" pipe and 4" aluminum cap at location of an old wood post set by County Surveyor in 1926. Witnesses:  
8" Cedar, S76°E 40.6' 6" Cedar, S44°W 12.1' 6" Cedar, N47°E 15.05'

B. Description of corner evidence found and/or method applied in restoring or reestablishing corner:

I-9 (T45N, R1W)  
This corner is being perpetuated as part of the Chippewa County Remonumentation Program.  
Found a 1" iron pipe with a 4" aluminum DNR cap and one cedar bearing tree as called for in liber 1, page 300. Accepted corner as found and established new bearing trees.



C. Description of monument for corner and accessories established to perpetuate locating the position of the corner:

I-9 (T45N, R1W)  
Corner is a 1" iron pipe with a 4" aluminum DNR cap. Witnesses:

- 8" Cedar, S44°W 11.42'
- 11" Cedar, N11°E 38.19'
- 15" Cedar, N83°W 30.19'
- 9" Cedar, N33°W 20.85'

Note: Distances are to a nail and tag in the side of the tree. Trees are blazed and painted. Bearings are compass bearings corrected for declination.

Signed by Keith R. Waters

Date 12-23-94

Surveyor's Michigan License No. 33142