

SURVEY & REMONUMENTATION

CHIPPEWA COUNTY REMONUMENTATION CORNER

APR 26 1995

LAND CORNER RECORDATION CERTIFICATE

Filing Requirement of Act 74, Mich. P.A. 1970

COMMISSION

For corners in Chippewa

Located In: _____ Corner Code # _____

(County) _____


1. Public Land Survey T 45N R 1W I-11
 T _____ R _____
 T _____ R _____
 T _____ R _____

2. Property Controlling S _____ T _____
 in Section S _____ T _____

3. Miscellaneous S _____ T _____
 Property in Sec. S _____ T _____

4. Lot No. _____, Recorded Plat _____

5. Private Claims _____

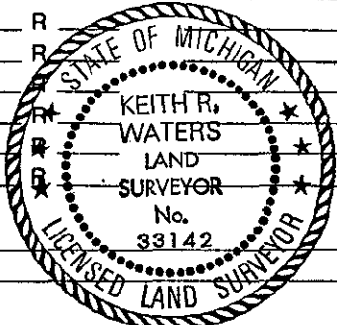

\$ 7.00 LAND CORNER
 \$ 2.00 MSSR
 19 JAN 95 4:17 P.M. RECEIPT# 2266
 RECEIVED FOR RECORD
 CHIPPEWA COUNTY - STATE OF MICHIGAN
 SHARON H. KENNEDY, REGISTER OF DEEDS

Register of Deeds Stamp & File Number

	A	B	C	D	E	F	G	H	I	J	K	L	M
2	6	5	4	3	2								
3													
4	7	8	9	10	11	12							
5													
6	18	17	16	15	14	13							
7													
8	19	20	21	22	23	24							
9													
10	30	29	28	27	26	25							
11													
12	31	32	33	34	35	36							
13													

I, Keith R. Waters, in a field survey on August 4, 1994, do hereby certify that under requirements of P.A. 74, Michigan P.A. of 1970, the corner points mentioned in lines 1 and 2 above were in conformance with regulations and rules therefore as required in the current manual of survey instructions of the United States Department of the Interior, Bureau of Land Management or by a decree of a Court of Law and/or that the corner points mentioned in lines 3, 4 and 5 above were in conformance with the rules of the Michigan Board of Land Surveyors or by a Decree of a Court of Law; established, re-established, monumented, re-monumented, recovered, found as expressed below:

NOTE: Not more than 4 corners, all in the same town and range, may be recorded on this certificate.

A. Description of original monument and accessories and/or subsequent restoration:

I-11 Corner Common to Sections 26, 27, 34, & 35, T45N, R1W.

Original ties to post: Maple 24, N55°E 11 links Sugar 12, S60°W 30 links.
 1963 - Corner is called for in the recorded plat of Fred's Subdivision.
 1980 - As recorded in liber 5, page 97, Chippewa County corner records, by Billy Buckler, RLS 8887. 1" iron pipe in monument box.
 1992 - as recorded in liber 8, page 294, Chippewa County corner records, by Neil E. Hill, P.S. 27447. Found 1" iron pipe in monument box.

B. Description of corner evidence found and/or method applied in restoring or reestablishing corner:

I-11 (T45N, R1W)
 This corner is being perpetuated as part of the Chippewa County Remonumentation Program.
 Found a 1" pipe in a monument box north of the centerline of Tone Road (M-80) as called for in liber 8, page 294. Position works well with found monumentation in Fred's Subdivision. Offset iron with witness hubs prior to re-construction of Tone Road. Monument box is to be placed in spring, 1995.

C. Description of monument for corner and accessories established to perpetuate locating the position of the corner:

I-11 (T45N, R1W)
 Corner is a 3/4" x 24" rebar with a plastic Chippewa County Remonumentation cap in a monument box to be placed in spring, 1995. Witnesses:

MDOT Tag in 12" Red Maple, S35°E 61.32' Note: Bearings are based on MDOT records.
 MDOT Tag in 11" Red Maple, S40°W 57.71'
 MDOT Tag in 4" Oak, N40°W 61.64'
 MDOT Tag in 20" Oak, N40°E 86.49'



Signed by Keith R. Waters Date 12-23-94

Surveyor's Michigan License No. 33142