

SURVEY & REMONUMENTATION

CHIPPEWA COUNTY REMONUMENTATION CORNER


APR 26 1995

LAND CORNER RECORDATION CERTIFICATE
Filing Requirement of Act 74, Mich. P.A. 1970

For corner in **CHIPPEWA**
 (County)

Located In: _____ Corner Code # _____

- 1. Public Land Survey T 45N R 1W I-12
- T _____ R _____
- T _____ R _____
- T _____ R _____
- 2. Property Controlling S _____ T _____ R _____
- in Section S _____ T _____ R _____
- 3. Miscellaneous S _____ T _____ R _____
- Property in Sec. S _____ T _____ R _____
- 4. Lot No. _____, Recorded Plat _____
- 5. Private Claims _____

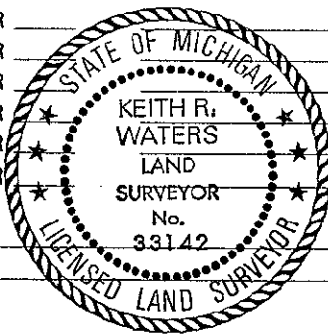

\$ 7.00 LAND CORNER
 \$ 2.00 MSSR
 5 DEC 94 12:35 P.M. RECEIPT# 1520
 RECEIVED FOR RECORD
 CHIPPEWA COUNTY - STATE OF MICHIGAN
 SHARON H. KENNEDY, REGISTER OF DEEDS
 Register of Deeds Stamp & File Number

	A	B	C	D	E	F	G	H	I	J	K	L	M
2	6	5	4	3	2	1							
3													
4	7	8	9	10	11	12							
5													
6	18	17	16	15	14	13							
7													
8	19	20	21	22	23	24							
9													
10	30	29	28	27	26	25							
11													
12	31	32	33	34	35	36							
13													

I, Keith R. Waters in a field survey on June 27, 19 94
do hereby certify that under requirements of P.A. 74, Michigan P.A. of 1970, the corner points mentioned in lines 1 and 2 above were in conformance with regulations and rules therefore as required in the current manual of survey instructions of the United States Department of the Interior, Bureau of Land Management or by a decree of a Court of Law and/or that the corner points mentioned in lines 3, 4 and 5 above were in conformance with the rules of the Michigan Board of Land Surveyors or by a Decree of a Court of Law; established, re-established, monumented, re-monumented, recovered, found as expressed below:

NOTE: Not more than 4 corners, all in the same town and range, may be recorded on this certificate.

A. Description of original monument and accessories and/or subsequent restoration:

I-12 1/4 Corner Common to Sections 34 & 35, T45N, R1W.

Original ties to post: Sugar 6, S80°E 10 links
 Hemlock 24, N24°W 21 links

1975 - A survey by Neree D. Alix, RLS 6254, shows the West 1/4 corner of Section 34 and also shows a bearing on the east-west 1/4 line to a found iron at what appears to be the center of Section 34, however no location in shown for the East 1/4 corner of Section 34.

B. Description of corner evidence found and/or method applied in restoring or reestablishing corner:

I-12 (T45N, R1W)

This corner is being re-established as part of the Chippewa County Remonumentation Program.

Found no evidence of corner. Re-established corner at the base of a large fallen over corner fence post at the intersection of old fence lines to the south and west. This position works very well with the bearing of the east-west 1/4 line of Section 34 as shown in above mentioned survey by Alix. It also appears that the found iron at the center of Section 34 as shown in said survey may have been established mid-way on line between this position and the West 1/4 corner of Section 34. Corner is 2599.93 feet from Section corner to the north, 2850.24 feet from standard Section corner to the south, and is 19.82 feet east of a straight line between said Section corners.

C. Description of monument for corner and accessories established to perpetuate locating the position of the corner:

I-12 (T45N, R1W)

Corner is a 3/4" x 24" rebar with 3 1/4" aluminum Chippewa County Remonumentation cap at the base of corner fence post (Fences south and west). Witnesses:

- 11" Sugar Maple, N87°E 16.79'
- 9" Sugar Maple, S42°E 11.87'
- 11" Sugar Maple, S33°W 25.43'
- 13" Sugar Maple, N70°W 16.54'

Note: Distances are to a nail and tag in the side of the tree. Trees are blazed and painted. Bearings are compass bearings corrected for declination.

Signed by Keith R. Waters

Date 12-1-94

Surveyor's Michigan License No. 33142

