

SURVEY & REMONUMENTATION

CHIPPEWA COUNTY REMONUMENTATION CORNER

APR 26 1995

LAND CORNER RECORDATION CERTIFICATE
Filing Requirement of Act 74, Mich. P.A. 1970

COMMISSION


For corners in
Chippewa

(County)

Located In:

Corner Code #

1. Public Land Survey T45N R1W I-13
 T _____ R _____
 T _____ R _____
 T _____ R _____
 T _____ R _____
2. Property Controlling in Section S _____ T _____ R _____
 S _____ T _____ R _____
3. Miscellaneous Property in Sec. S _____ T _____ R _____
 S _____ T _____ R _____
4. Lot No. _____, Recorded Plat _____
5. Private Claims _____

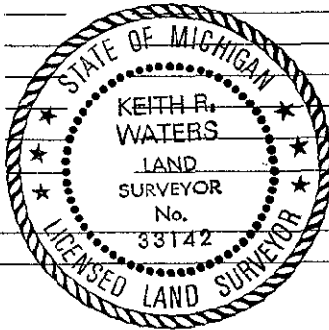

\$ 7.00 LAND CORNER
 \$ 2.00 MSSR
 24 OCT 94 3:49 P.M. RECEIPT# 831
 RECEIVED FOR RECORD
 CHIPPEWA COUNTY - STATE OF MICHIGAN
 SHARON H. KENNEDY, REGISTER OF DEEDS

Register of Deeds Stamp & File Number

	A	B	C	D	E	F	G	H	I	J	K	L	M
2	6		5		4		3		2		1		
3													
4	7		8		9		10		11		12		
5													
6	18		17		16		15		14		13		
7													
8	19		20		21		22		23		24		
9													
10	30		29		28		27		26		25		
11													
12	31		32		33		34		35		36		
13													

I, Keith R. Waters, in a field survey on May 25, 1994, do hereby certify that under requirements of P.A. 74, Michigan P.A. of 1970, the corner points mentioned in lines 1 and 2 above were in conformance with regulations and rules therefore as required in the current manual of survey instructions of the United States Department of the Interior, Bureau of Land Management or by a decree of a Court of Law and/or that the corner points mentioned in lines 3, 4 and 5 above were in conformance with the rules of the Michigan Board of Land Surveyors or by a Decree of a Court of Law; established, re-established, monumented, re-monumented, recovered, found as expressed below:

NOTE: Not more than 4 corners, all in the same town and range, may be recorded on this certificate.

A. Description of original monument and accessories and/or subsequent restoration:

I-13 Corner Common to Sections 34 & 35, on South Boundary of T45N, R1W.
 (Standard Corner on Township Line)
 Original ties to post: Fir 6, N78°E 13 links
 Fir 7, N09°W 12 links
 1962 - Corner recorded in liber 3, page 125, Chippewa County corner records,
 B. Buckler, RLS, 8887. Set 1" pipe and with 4" aluminum cap. Witnesses:
 15" Red Oak, N63°W 55 links - 11" Hard Maple, N48°E 24.42'

B. Description of corner evidence found and/or method applied in restoring or reestablishing corner:

I-13 (T45N, R1W)
 This corner is being perpetuated as part of the Chippewa County Remonumentation Program.
 Found a 1" pipe with 4" aluminum DNR cap on the north edge of a 2-track road to the west at the intersection of a 2-track road to the south, both bearing trees are gone. Buckler's corner form indicates that east-west position was established using a fence line to the north, north-south position established using road to the west. Found remains of the fence line to the north, east-west position also works well with Section corner to the west. I believe that the north-south position of this corner is somewhat questionable. However, other corners have been established and surveys have been done using this position, and having nothing to prove otherwise, I am accepting as found.

C. Description of monument for corner and accessories established to perpetuate locating the position of the corner:

I-13 (T45N, R1W)
 Corner is 1" diameter pipe with 4" aluminum DNR cap on the north edge of a 2-track road to the west at intersection of a 2-track road to the south.
 Witnesses:
 8" Oak, S15°W 30.61'
 9" Oak, S44°W 31.46'
 11" Oak, N09°E 29.44'
 9" Sugar Maple, N78°E 34.43'
 3/4" Rebar w/aluminum cap
 (Closing Corner), EAST 13.20'

Note: Distances are to a nail and tag in the side of the witness object. Trees are blazed and painted. Bearings are compass bearings corrected for declination.

Signed by Keith R. Waters
 Surveyor's Michigan License No. 33142

Date 10-18-94

