

**SURVEY &
REMONUMENTATION**

CHIPPEWA COUNTY REMONUMENTATION CORNER

APR 26 1995

LAND CORNER RECORDATION CERTIFICATE
Filing Requirement of Act 74, Mich. P.A. 1970

For corners in Chippewa **COMMISSION**

Located In: _____ Corner Code #/ # _____
(County)


1. Public Land Survey T 45N R 1W J-7
T _____ R _____
T _____ R _____
T _____ R _____

2. Property Controlling S _____ T _____ R _____
in Section S _____ T _____ R _____

3. Miscellaneous S _____ T _____
Property in Sec. S _____ T _____

4. Lot No. _____, Recorded Plat _____

5. Private Claims _____

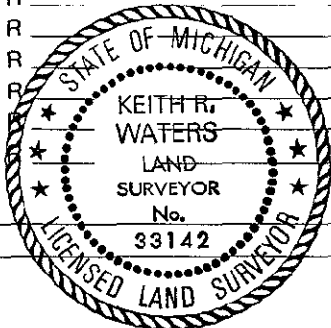

\$ 7.00 LAND CORNER
\$ 2.00 MSSR
24 OCT 94 3:49 P.M. RECEIPT# 831
RECEIVED FOR RECORD
CHIPPEWA COUNTY - STATE OF MICHIGAN
SHARON H. KENNEDY, REGISTER OF DEEDS

Register of Deeds Stamp & File Number

	A	B	C	D	E	F	G	H	I	J	K	L	M
2	6	5	4	3	2	1							
3													
4	7	8	9	10	11	12							
5													
6	18	17	16	15	14	13							
7													
8	19	20	21	22	23	24							
9													
10	30	29	28	27	26	25							
11													
12	31	32	33	34	35	36							
13													

I, Keith R. Waters in a field survey on February 14, 19 94, do hereby certify that under requirements of P.A. 74, Michigan P.A. of 1970, the corner points mentioned in lines 1 and 2 above were in conformance with regulations and rules therefore as required in the current manual of survey instructions of the United States Department of the Interior, Bureau of Land Management or by a decree of a Court of Law and/or that the corner points mentioned in lines 3, 4 and 5 above were in conformance with the rules of the Michigan Board of Land Surveyors or by a Decree of a Court of Law; established, re-established, monumented, re-monumented, recovered, found as expressed below:

NOTE: Not more than 4 corners, all in the same town and range, may be recorded on this certificate.

A. Description of original monument and accessories and/or subsequent restoration:

J-7 1/4 Corner Common to Sections 14 & 23, T45N, R1W

Original ties to post: White Pine 16, N43°E 16 links
Hemlock 8, S46°W 24 links

1959 - This corner is recorded in liber 3, page 25, Chippewa County corner records, by Billy Buckler, P.S. 8887, as a 1" pipe with 4" brass cap.

Record witnesses: 8" Tamarack, N53°E 24 1/2 links - 9" Cedar, S43°E 66 links
6" Tamarack, S12°W 54 1/2 links

Corner is on north edge of old east-west road.

B. Description of corner evidence found and/or method applied in restoring or reestablishing corner:

J-7 (T45N, R1W)

This corner is being perpetuated as part of the Chippewa County Remonumentation Program.

Found a 1" iron pipe with 4" brass cap stamped "Michigan Department of Conservation - Forestry Division" on the north edge of an east-west 2-track road. Also found Buckler's 8" tamarack bearing tree, which checks well.

Buckler's corner form indicates that he established corner position from an original white pine bearing tree. Accepted corner as found and established new witness objects.

C. Description of monument for corner and accessories established to perpetuate locating the position of the corner:

J-7 (T45N, R1W)

Corner is 1" iron pipe with a 4" brass cap on the north edge of an east-west 2-track road. Witnesses:

- 8" Spruce, S19°W 27.47'
- 7" Spruce, S16°E 19.98'
- 10" Tamarack, N56°E 16.67'
- 7" Spruce, N24°W 10.08'

Note: Distances are to a nail and tag in the side of the tree. Trees are blazed and painted. Bearings are compass bearings corrected for declination.

Signed by Keith R. Waters

Date 10-18-94

Surveyor's Michigan License No. 33142

