

**SURVEY & REMONUMENTATION**

APR 26 1995

CHIPPEWA COUNTY REMONUMENTATION CORNER


COMMISSION

LAND CORNER RECORDATION CERTIFICATE  
Filing Requirement of Act 74, Mich. P.A. 1970

For corners in  
Chippewa  
(County)

Located In: Corner Code #

- 1. Public Land Survey T 45N R 1W K-12
- T \_\_\_\_\_ R \_\_\_\_\_
- T \_\_\_\_\_ R \_\_\_\_\_
- T \_\_\_\_\_ R \_\_\_\_\_
- 2. Property Controlling S \_\_\_\_\_ T \_\_\_\_\_ R \_\_\_\_\_
- in Section S \_\_\_\_\_ T \_\_\_\_\_ R \_\_\_\_\_
- 3. Miscellaneous S \_\_\_\_\_ T \_\_\_\_\_ R \_\_\_\_\_
- Property in Sec. S \_\_\_\_\_ T \_\_\_\_\_ R \_\_\_\_\_
- 4. Lot No. \_\_\_\_\_, Recorded Plat \_\_\_\_\_
- 5. Private Claims \_\_\_\_\_

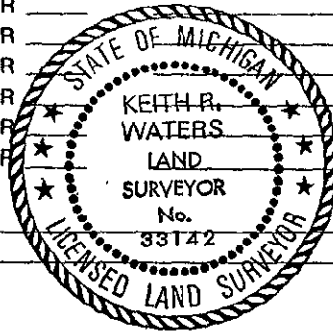

\$ 7.00 LAND CORNER  
\$ 2.00 MSSR  
19 JAN 95 4:18 P.M. RECEIPT# 2266  
RECEIVED FOR RECORD  
CHIPPEWA COUNTY - STATE OF MICHIGAN  
SHARON H. KENNEDY, REGISTER OF DEEDS  
Register of Deeds Stamp & File Number

	A	B	C	D	E	F	G	H	I	J	K	L	M
2	6	5	4	3	2	1							
3													
4	7	8	9	10	11	12							
5													
6	18	17	16	15	14	13							
7													
8	19	20	21	22	23	24							
9													
10	30	29	28	27	26	25							
11													
12	31	32	33	34	35	36							
13													

I, Keith R. Waters in a field survey on November 28, 19 94, do hereby certify that under requirements of P.A. 74, Michigan P.A. of 1970, the corner points mentioned in lines 1 and 2 above were in conformance with regulations and rules therefore as required in the current manual of survey instructions of the United States Department of the Interior, Bureau of Land Management or by a decree of a Court of Law and/or that the corner points mentioned in lines 3, 4 and 5 above were in conformance with the rules of the Michigan Board of Land Surveyors or by a Decree of a Court of Law; established, re-established, monumented, re-monumented, recovered, found as expressed below:

NOTE: Not more than 4 corners, all in the same town and range, may be recorded on this certificate.

A. Description of original monument and accessories and/or subsequent restoration:

K-12 1/4 Corner Common to Sections 35 & 36, T45N, R1W.

Original ties to post: Hemlock 24, S56°W 47 links Birch 12, N60°E 21 links.

Corner is shown on a drawing of a subdivision of Section 36, by William L. Karr, P.S. 27450, mid-way on line between sections corners north and south.

B. Description of corner evidence found and/or method applied in restoring or reestablishing corner:

K-12 (T45N, R1W)

This corner is being re-established as part of the Chippewa County Remonumentation Program.

Found no evidence of corner. Re-established corner by single proportionate measurement on line between section corners 2673.98 feet north and 2673.98 feet south. Position works well with that as shown in above mentioned sketch of subdivision of Section 36.

C. Description of monument for corner and accessories established to perpetuate locating the position of the corner:

K-12 (T45N, R1W)

Corner is a 3/4" x 24" rebar with 3/4" aluminum Chippewa County Remonumentation cap. Witnesses:

- 10" White Pine, S36°E 34.88'
- 4" Spruce, S73°W 17.29'
- 12" Tamarack, N03°E 31.42'
- 15" White Pine, N80°E 32.42'

Note: Distances are to a nail and tag in the side of the tree. Trees are blazed and painted. Bearings are compass bearings corrected for declination.



Signed by Keith R. Waters

Date 12-23-94

Surveyor's Michigan License No. 33142