

**SURVEY &
REMONUMENTATION**

APR 26 1995

CHIPPEWA COUNTY REMONUMENTATION CORNER

LAND CORNER RECORDATION CERTIFICATE

Filing Requirement of Act 74, Mich. P.A. 1970

For corners of **COMMISSION**

<u>Chippewa</u> (County)	Located In:	Corner Code #
1. Public Land Survey	T <u>45N</u> R <u>1W</u>	<u>L-1</u>
	T _____ R _____	_____
	T _____ R _____	_____
2. Property Controlling in Section	S _____ T _____ R _____	_____
	S _____ T _____ R _____	_____
3. Miscellaneous Property in Sec.	S _____ T _____ R _____	_____
	S _____ T _____ R _____	_____

\$ 7.00 LAND CORNER
\$ 2.00 HSSR
5 DEC 94 12:27 P.M. RECEIPT 1518
RECEIVED FOR RECORD
CHIPPEWA COUNTY - STATE OF MICHIGAN
SHARON H. KENNEDY, REGISTER OF DEEDS

Register of Deeds Stamp & File Number

4. Lot No. _____, Recorded Plat _____
5. Private Claims _____

I, William L. Karr, in a field survey on October 28, 1994, do hereby certify that under requirements of P.A. 74, Michigan P.A. of 1970, the corner points mentioned in lines 1 and 2 above were in conformance with regulations and rules therefore as required in the current manual of survey instructions of the United States Department of the Interior, Bureau of Land Management or by a decree of a Court of Law and/or that the corner points mentioned in lines 3, 4 and 5 above were in conformance with the rules of the Michigan Board of Land Surveyors or by a Decree of a Court of Law; established, re-established, monumented, re-monumented, recovered, found as expressed below:

NOTE: Not more than 4 corners, all in the same town and range, may be recorded on this certificate.

A. Description of original monument and accessories and/or subsequent restoration:

(L-1) North 1/4 Corner Section 1, T.45 N., R.1 W (Not common)

Not set in original survey.

1982: W.L. Karr set a 1/2" iron w/cap No. 27450 on the extension of a fence line to the South and on the Township line (L.6, P.30).

Witnesses: 8" Cedar N25E 51.34'
Twin 8" Birch S38E 41.14'
10" Balsam South 33.35'
8" Aspen N11W 26.38'

B. Description of corner evidence found and/or method applied in restoring or reestablishing corner:



(L-1) This corner is being perpetuated as part of the Chippewa County Remonumentation program.

Found no evidence of original corner. Found a 1/2" pin w/cap No. 27450 and several of the witnesses as recorded in 1982. Also found a 1/2" iron w/cap No. 27450, 5.94' to the West (South 1/4 Corner Section 36). Accepted corner position as found.

C. Description of monument for corner and accessories established to perpetuate locating the position of the corner:

(L-1) Corner is a 1/2" iron w/cap No. 27450, 2' North of the centerline of 12 Mile Road.

Witnesses: 8" Spruce N07°E 30.68'
12" Cedar N23°E 51.21'
6" Cedar S20°E 36.07'
12" Balsam Fir S05°W 33.46'
12" Aspen N13°W 26.37'
South 1/4 Corner Section 36 West 5.94'

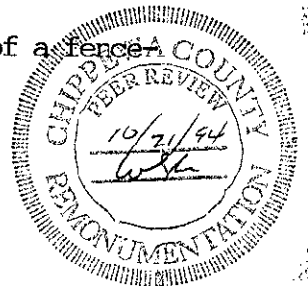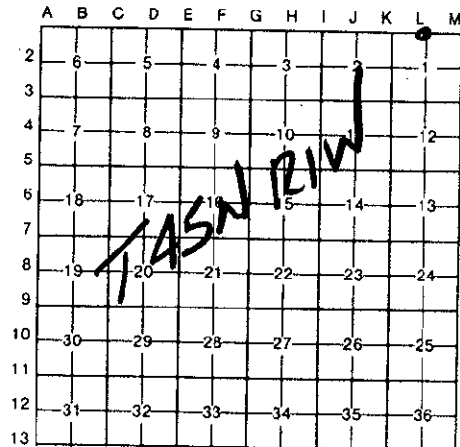

Signed by William L. Karr Date 12/21/94

Surveyor's Michigan License No. 27450

723-12

NOTE: Bearings are compass bearings corrected for declination.
Distances are to a nail in side of witness objects unless noted.