

**SURVEY & REMONUMENTATION CHIPPEWA COUNTY REMONUMENTATION CORNER**


APR 26 1995

**LAND CORNER RECORDATION CERTIFICATE**  
Filing Requirement of Act 74, Mich. P.A. 1970

For corners in  
**Chippewa** COMMISSION  
(County)

Located In: \_\_\_\_\_ Corner Code # \_\_\_\_\_

- 1. Public Land Survey T 45N R 1W L-7  
T \_\_\_\_\_ R \_\_\_\_\_  
T \_\_\_\_\_ R \_\_\_\_\_  
T \_\_\_\_\_ R \_\_\_\_\_
- 2. Property Controlling S \_\_\_\_\_ T \_\_\_\_\_ R \_\_\_\_\_  
in Section S \_\_\_\_\_ T \_\_\_\_\_ R \_\_\_\_\_
- 3. Miscellaneous S \_\_\_\_\_ T \_\_\_\_\_ R \_\_\_\_\_  
Property in Sec. S \_\_\_\_\_ T \_\_\_\_\_ R \_\_\_\_\_
- 4. Lot No. \_\_\_\_\_, Recorded Plat \_\_\_\_\_
- 5. Private Claims \_\_\_\_\_

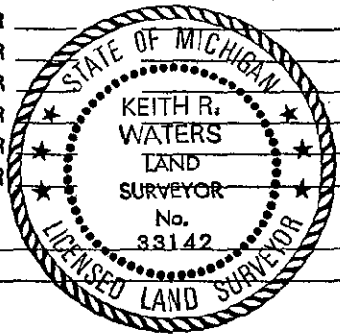

\$ 7.00 LAND CORNER  
\$ 2.00 NSSR  
19 JAN 95 4:18 P.M. RECEIPT# 2266  
RECEIVED FOR RECORD  
CHIPPEWA COUNTY - STATE OF MICHIGAN  
SHARON H. KENNEDY, REGISTER OF DEEDS  
**Register of Deeds Stamp & File Number**

	A	B	C	D	E	F	G	H	I	J	K	L	M
2	6		5		4		3		2		1		
3													
4	7		8		9		10		11		12		
5													
6	15		17		16		15		14		13		
7													
8	19		20		21		22		23		24		
9													
10	30		29		28		27		26		25		
11													
12	31		32		33		34		35		36		
13													

I, Keith R. Waters in a field survey on October 31, 19 94, do hereby certify that under requirements of P.A. 74, Michigan P.A. of 1970, the corner points mentioned in lines 1 and 2 above were in conformance with regulations and rules therefore as required in the current manual of survey instructions of the United States Department of the Interior, Bureau of Land Management or by a decree of a Court of Law and/or that the corner points mentioned in lines 3, 4 and 5 above were in conformance with the rules of the Michigan Board of Land Surveyors or by a Decree of a Court of Law; established, re-established, monumented, re-monumented, recovered, found as expressed below:

**NOTE: Not more than 4 corners, all in the same town and range, may be recorded on this certificate.**

**A. Description of original monument and accessories and/or subsequent restoration:**

L-7 1/4 Corner Common to Section 13 & 24, T45N, R1W.


Original ties to post: Sugar 10, N14°E 38 links Fir 6, S19°E 06 links.  
1974 - As recorded in liber 1, page 139, Chippewa County corner records, by Billy Buckler, RLS 8887. Set 1" pipe 33 feet north of an old fence corner. Witnesses: 13" Hard Maple N18°E 58.0', 20" Y. Birch N38°W 84.5  
1986, 1989 - Corner is shown on surveys by Earl Strater, P.S. 28424, and Karr, P.S. 27450. Witnesses: Twin 6" Oak, S38°W 29.14' 24" Yellow Birch, N40°W 84.57' 4" Sugar Maple, N18°E 58.05'

**B. Description of corner evidence found and/or method applied in restoring or reestablishing corner:**

L-7 (T45N, R1W)  
This corner is being perpetuated as part of the Chippewa County Remonumentation Program.  
Found a bent iron pipe with a DNR cap on the north side of east-west gravel road (15 Mile Road). Also found three bearing trees as shown in above mentioned surveys, two of which are those as shown in liber 1, page 139. Dug up bent iron and found base, replaced with a 3/4" rebar and a plastic Chippewa County Remonumentation cap.

**C. Description of monument for corner and accessories established to perpetuate locating the position of the corner:**

L-7 (T45N, R1W)  
Corner is a 3/4" x 24" rebar with a plastic Chippewa County Remonumentation cap approximately 12 feet north of the centerline of 15 Mile Road. Witnesses:  
8" White Pine, N66°W 37.29'  
Twin 8" Oak, S38°W 29.21'  
16" Sugar Maple, N18°E 57.82'  
22" Yellow Birch, N40°W 84.42'  
Note: Distances are to a nail in the side of the tree. Trees are blazed and painted. (Oak has side blaze only). Bearings are compass bearings corrected for declination.

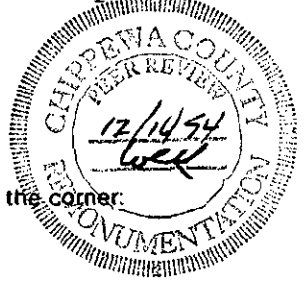

Signed by Keith R. Waters Date 12-23-94  
Surveyor's Michigan License No. 33142