

SURVEY & REMONUMENTATION

CHIPPEWA COUNTY REMONUMENTATION CORNER

APR 26 1995

LAND CORNER RECORDATION CERTIFICATE

Filing Requirement of Act 74, Mich. P.A. 1970

For corners in **CHIPPEWA** COMMISSION

Located In: _____ Corner Code #/

T 45N R 1W L-9


1. Public Land Survey T _____ R _____

2. Property Controlling in Section S _____ T _____ R _____

3. Miscellaneous Property in Sec. S _____ T _____ R _____

4. Lot No. _____, Recorded Plat _____

5. Private Claims _____

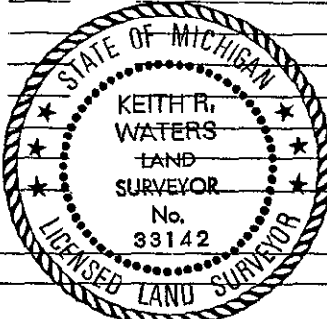

\$ 7.00 LAND CORNER
 \$ 2.00 MSSR
 19 JAN 95 4:19 P.M. RECEIPT# 2266
 RECEIVED FOR RECORD
 CHIPPEWA COUNTY - STATE OF MICHIGAN
 SHARDN H. KENNEDY, REGISTER OF DEEDS

Register of Deeds Stamp & File Number

	A	B	C	D	E	F	G	H	I	J	K	L	M
2	6		5		4		3		2		1		
3													
4	7		8		9		10		11		12		
5													
6	18		17		16		15		14		13		
7													
8	19		20		21		22		23		24		
9													
10	30		29		28		27		26		25		
11													
12	31		32		33		34		35		36		
13													

Keith R. Waters November 29 1994

I, Keith R. Waters, in a field survey on _____, 1994, do hereby certify that under requirements of P.A. 74, Michigan P.A. of 1970, the corner points mentioned in lines 1 and 2 above were in conformance with regulations and rules therefore as required in the current manual of survey instructions of the United States Department of the Interior, Bureau of Land Management or by a decree of a Court of Law and/or that the corner points mentioned in lines 3, 4 and 5 above were in conformance with the rules of the Michigan Board of Land Surveyors or by a Decree of a Court of Law; established, re-established, monumented, re-monumented, recovered, found as expressed below:

NOTE: Not more than 4 corners, all in the same town and range, may be recorded on this certificate.

A. Description of original monument and accessories and/or subsequent restoration:

L-9 1/4 Corner Common to Sections 24 & 25, T45N, R1W.

Original ties to post: Birch 30, N45°W 11 links Cedar 12, S45°E 30 links.
 1965 - Highway Department, as recorded in liber 3, page 222, Chippewa County corner records. Found 1 1/4" iron pipe.
 1982 - As recorded in liber 6, page 135, Chippewa County corner records, by William L. Karr, P.S. 27450. Found a 3/4" iron bar 2 feet south of the centerline of east-west trail. Witnesses: 12" Spruce, S66°E 33.50' 8" Spruce, S38°W 12.95' 4" Maple, N11°W 25.95'

B. Description of corner evidence found and/or method applied in restoring or reestablishing corner:

L-9 (T45N, R1W)
 This corner is being perpetuated as part of the Chippewa County Remonumentation Program.
 Found a 3/4" iron bar 2 feet south of the centerline of an east-west trail on the westerly extension of an east-west gravel road (16 Mile Road). Also found 8" Spruce and 4" Maple bearing trees as called for in liber 6, page 135. Distance east to the southeast corner of section 24 and the angle at the southeast corner of section 24 match very well with those as shown in old County Surveyor notes. Accepted corner as found, placed a plastic Chippewa County Remonumentation cap on 3/4" bar, and added new bearing trees.

C. Description of monument for corner and accessories established to perpetuate locating the position of the corner:

L-9 (T45N, R1W)
 Corner is a 3/4" iron with a plastic Chippewa County Remonumentation cap 2 feet south of the centerline of an east-west trail on the westerly extension of 16 Mile Road. Witnesses:
 12" Spruce, S38°W 13.04'
 10" Maple, N11°W 25.70'
 12" Spruce, N49°W 47.09'
 10" Spruce, S60°E 41.17'

Note: Distances are to a nail and tag in the side of the tree. Trees are blazed and painted. Bearings are compass bearings corrected for declination.

Signed by Keith R. Waters Date 12-23-94

Surveyor's Michigan License No. 33142

