

1993

CHIPPEWA COUNTY REMONUMENTATION CORNER

RECEIVED FOR RECORD
CHIPPEWA COUNTY
STATE OF MICHIGAN

COMMISSION

LAND CORNER RECORDATION CERTIFICATE

Filing Requirement of Act 74, Mich. P.A. 1970

93 DEC -3 PM 3: 58

For corners in
Chippewa

(County)

Located In:

Corner Code ##


1. Public Land Survey	T45N R 1E	A-3	Same
	T45N R 1W	M-3	Corner
	T _____ R _____		
	T _____ R _____		
2. Property Controlling in Section	S _____ T _____ R _____		
	S _____ T _____ R _____		
3. Miscellaneous Property in Sec.	S _____ T _____ R _____		
	S _____ T _____ R _____		

J. Roger Malick
REGISTER OF DEEDS

Register of Deeds Stamp & File Number

4. Lot No. _____, Recorded Plat _____
5. Private Claims _____

I, Keith R. Waters in a field survey on June 2, 19 93, do hereby certify that under requirements of P.A. 74, Michigan P.A. of 1970, the corner points mentioned in lines 1 and 2 above were in conformance with regulations and rules therefore as required in the current manual of survey instructions of the United States Department of the Interior, Bureau of Land Management or by a decree of a Court of Law and/or that the corner points mentioned in lines 3, 4 and 5 above were in conformance with the rules of the Michigan Board of Land Surveyors or by a Decree of a Court of Law; established, re-established, monumented, re-monumented, recovered, found as expressed below:

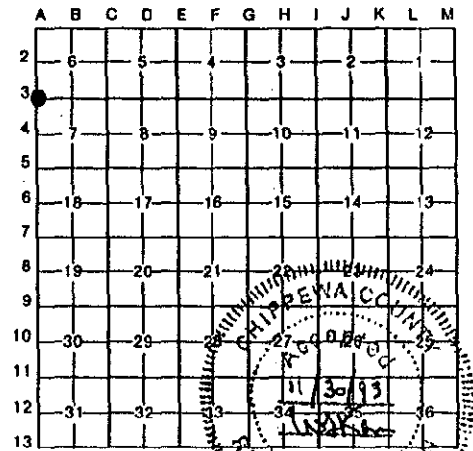

NOTE: Not more than 4 corners, all in the same town and range, may be recorded on this certificate.

A. Description of original monument and accessories and/or subsequent restoration:

A-3 (T45N, R1E)
Section Corner Common to Sections 6 & 7, T45N, R1E and Sections 1 & 12, T45N, R1W.

Michigan State Highway Department (11-29-65) as recorded in liber 2, page 234, of Chippewa County corner records: Found a 1" iron pin in monument box with the following ties: T. Pole, S65°W 60.28'
T. Pole, N70°W 92.90'
T. Pole, N65°E 58.88'

B. Description of corner evidence found and/or method applied in restoring or reestablishing corner:


A-3 (T45N, R1E)
This corner is being perpetuated as part of the Chippewa County Remonumentation Program.
Found a 1/2" iron pin in a monument box 1' east of centerline of Highway M-129 at the intersection of 13 Mile Road. (Monument box lid is missing). All witnesses from 1965 Highway Department records are gone. Distances to corners 1 mile north and 1 mile south match closely with those shown on Highway Department records. Accepted corner location as found and established new witness objects.

C. Description of monument for corner and accessories established to perpetuate locating the position of the corner:

A-3 (T45N, R1E)
Corner is a 1/2" iron pin in a monument box 1' east of centerline of Highway M-129 at the intersection of 13 Mile Road.

Witnesses:
N.E. corner block basement of Donaldson Presbyterian Church, S30°W 235.70'
7" White Birch, S63°W 192.19'
P. Pole (DR2-105), S77°E 185.65'
N.E. Corner of 4.1'x1.15' base of "Johnston" headstone in Donaldson Cemetery, N77°W 208.69'

Note: Distances to pole and birch (not blazed) are to a nail and tag in the side. Bearings are compass bearings corrected for declination. Distances measured with EDM.

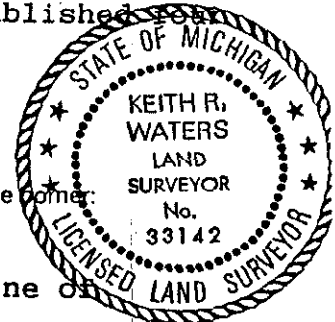

Signed by Keith R. Waters Date 11-30-93

Surveyor's Michigan License No. 33142