

1993

COMMISSION

CHIPPEWA COUNTY REMONUMENTATION CORNER CHIPPWEA COUNTY STATE OF MICHIGAN

LAND CORNER RECORDATION CERTIFICATE

Filing Requirement of Act 74, Mich. P.A. 1970 93 DEC -3 PM 3: 58

RECEIVED FOR RECORD CHIPPWEA COUNTY STATE OF MICHIGAN

For corners in Chippewa (County)

Located In: Corner Code =#

Table with 3 columns: Item, Located In, Corner Code. Row 1: Public Land Survey, T45N R 1E, A-7 Same M-7 Corner. Row 2: Property Controlling in Section, S T R. Row 3: Miscellaneous Property in Sec., S T R.

J. Roger Malott REGISTER OF DEEDS

Register of Deeds Stamp & File Number

4. Lot No. Recorded Plat 5. Private Claims

I, Keith R. Waters in a field survey on July 29, 19 93 do hereby certify that under requirements of P.A. 74, Michigan P.A. of 1970, the corner points mentioned in lines 1 and 2 above were in conformance with regulations and rules therefore as required in the current manual of survey instructions of the United States Department of the Interior, Bureau of Land Management or by a decree of a Court of Law and/or that the corner points mentioned in lines 3, 4 and 5 above were in conformance with the rules of the Michigan Board of Land Surveyors or by a Decree of a Court of Law; established, re-established, monumented, re-monumented, recovered, found as expressed below:

NOTE: Not more than 4 corners, all in the same town and range, may be recorded on this certificate.

A. Description of original monument and accessories and/or subsequent restoration:

A-7 (T45N, R1E) Section Corner Common to Sections 18 & 19, T45N, R1E and Sections 13 & 24, T45N, R1W).

Michigan State Highway Department (11-29-65) as recorded in liber 2, page 225, of Chippewa County corner records: Found 1/2" reinforcing rod in monument box with the following ties: T. Pole, S45°W 56.45' 24" Willow, N30°W 57.81' Sign Post, S35°E 89.65'


B. Description of corner evidence found and/or method applied in restoring or reestablishing corner:

A-7 (T45N, R1E) This corner is being perpetuated as part of the Chippewa County Remonumentation Program. Found a 1/2" iron pin in a monument box in the centerline of Highway M-129 at the intersection of 15 Mile Road. All witnesses from Highway Department records are gone. Distances to Section corners 1 mile north and 1 mile south check closely with those as shown on Highway Department records. Corner has been used in numerous surveys in all four adjacent Sections. Accepted as found and established four new witness objects.

C. Description of monument for corner and accessories established to perpetuate locating the position of the corner:

A-7 (T45N, R1E) Corner is a 1/2" iron pin in a monument box in the centerline of Highway M-129 at the intersection of 15 Mile Road. Witnesses: Power Pole (DR2-133-1), N47°E 167.89' Power Pole (DR2-134), N77°E 141.32' Power Pole, S75°W 75.24' Power Pole (DR2-134-1), N59°W 81.64'

Note: Distances are to a nail and tag in the side of witness object. Bearings are compass bearings corrected for declination. Distances are measured with EDM.

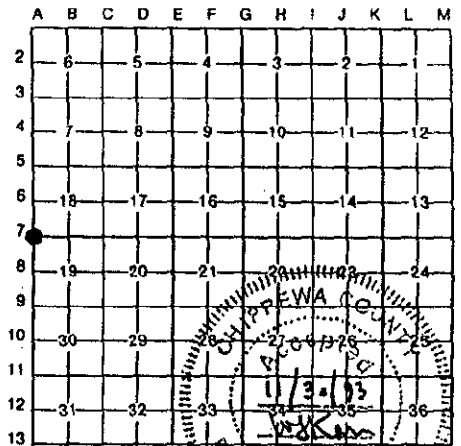

Signed by Keith R. Waters Date 11-30-93

Surveyor's Michigan License No. 33142