

1993

CHIPPEWA COUNTY REMONUMENTATION CORNER

RECEIVED FOR RECORD
CHIPPEWA COUNTY
STATE OF MICHIGAN

COMMISSION

LAND CORNER RECORDATION CERTIFICATE

Filing Requirement of Act 74, Mich. P.A. 1970

93 DEC -3 PM 3: 58

For corners in
Chippewa

(County)

Located In:

Corner Code #

1. Public Land Survey

T 45N R 1E

A-10 Same

T 45N R 1W

M-10 Corner

T R

T R

2. Property Controlling
In Section

S T R

S T R

3. Miscellaneous
Property in Sec.

S T R

-S T R

J. Roger Malott
REGISTER OF DEEDS

Register of Deeds Stamp & File Number

4. Lot No. _____, Recorded Plat _____
5. Private Claims _____

I, Keith R. Waters in a field survey on July 29, 1993
do hereby certify that under requirements of P.A. 74, Michigan P.A. of 1970, the corner points mentioned
in lines 1 and 2 above were in conformance with regulations and rules therefore as required in the
current manual of survey instructions of the United States Department of the Interior, Bureau of Land
Management or by a decree of a Court of Law and/or that the corner points mentioned in lines 3, 4 and 5
above were in conformance with the rules of the Michigan Board of Land Surveyors or by a Decree of a
Court of Law; established, re-established, monumented, re-monumented, recovered, found as
expressed below:

**NOTE: Not more than 4 corners, all in the same town and range, may be recorded
on this certificate.**

A. Description of original monument and accessories and/or subsequent restoration:

A-10 (T45N, R1E)

1/4 Corner Common to Section 30, T45N, R1E & Section 25, T45N, R1W.

Michigan State Highway Department (11-29-65) as recorded in liber 3, page 221,
of Chippewa County corner records: Found 1/2" reinforcing rod in monument box
with the following ties: 8" Twin Elm, N65°E 72.31'
8" Elm, S40°W 75.14'
Fence Post, N75°W 76.12'

B. Description of corner evidence found and/or method applied in restoring or reestablishing corner:

A-10 (T45N, R1E)

This corner is being perpetuated as part of the Chippewa County
Remonumentation Program.

Found a 1/2" iron pin in a monument box approximately 0.5' east of centerline
of Highway M-129. All witnesses from Highway Department records are gone.
Distances to Section corners 1/2 mile north and 1/2 mile south check closely
with Highway Department records. Accepted corner as found and established
four new witness objects.


C. Description of monument for corner and accessories established to perpetuate locating the position of the corner:

A-10 (T45N, R1E)

Corner is a 1/2" iron pin in a monument box 0.5' east of centerline of Highway
M-129. Witnesses:

- Power Pole, N58°E 91.94'
- 10" Balsam Fir, N83°E 100.37'
- 6" Red Maple, S78°W 87.18'
- Telephone Pole, N60°W 79.45'

Note: Distances are to a nail and tag in
the side of witness object. Trees are
blazed and painted. Bearings are compass
bearings corrected for declination.
Distances measured with EDM.

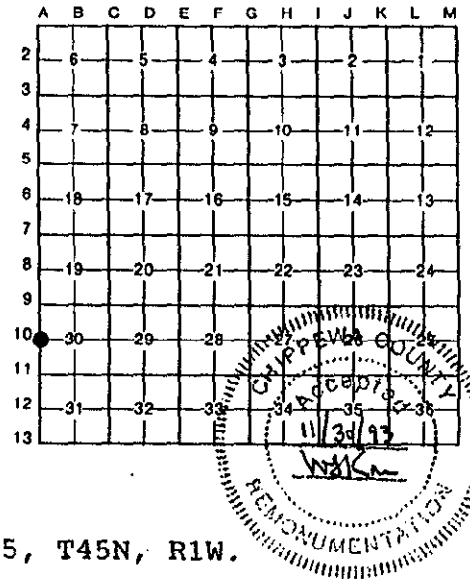

Signed by Keith R. Waters Date 11-30-93
Surveyor's Michigan License No. 33142