


SKETCH OF
 SEC. 27, T45N R1W
 CHIPPEWA CO.

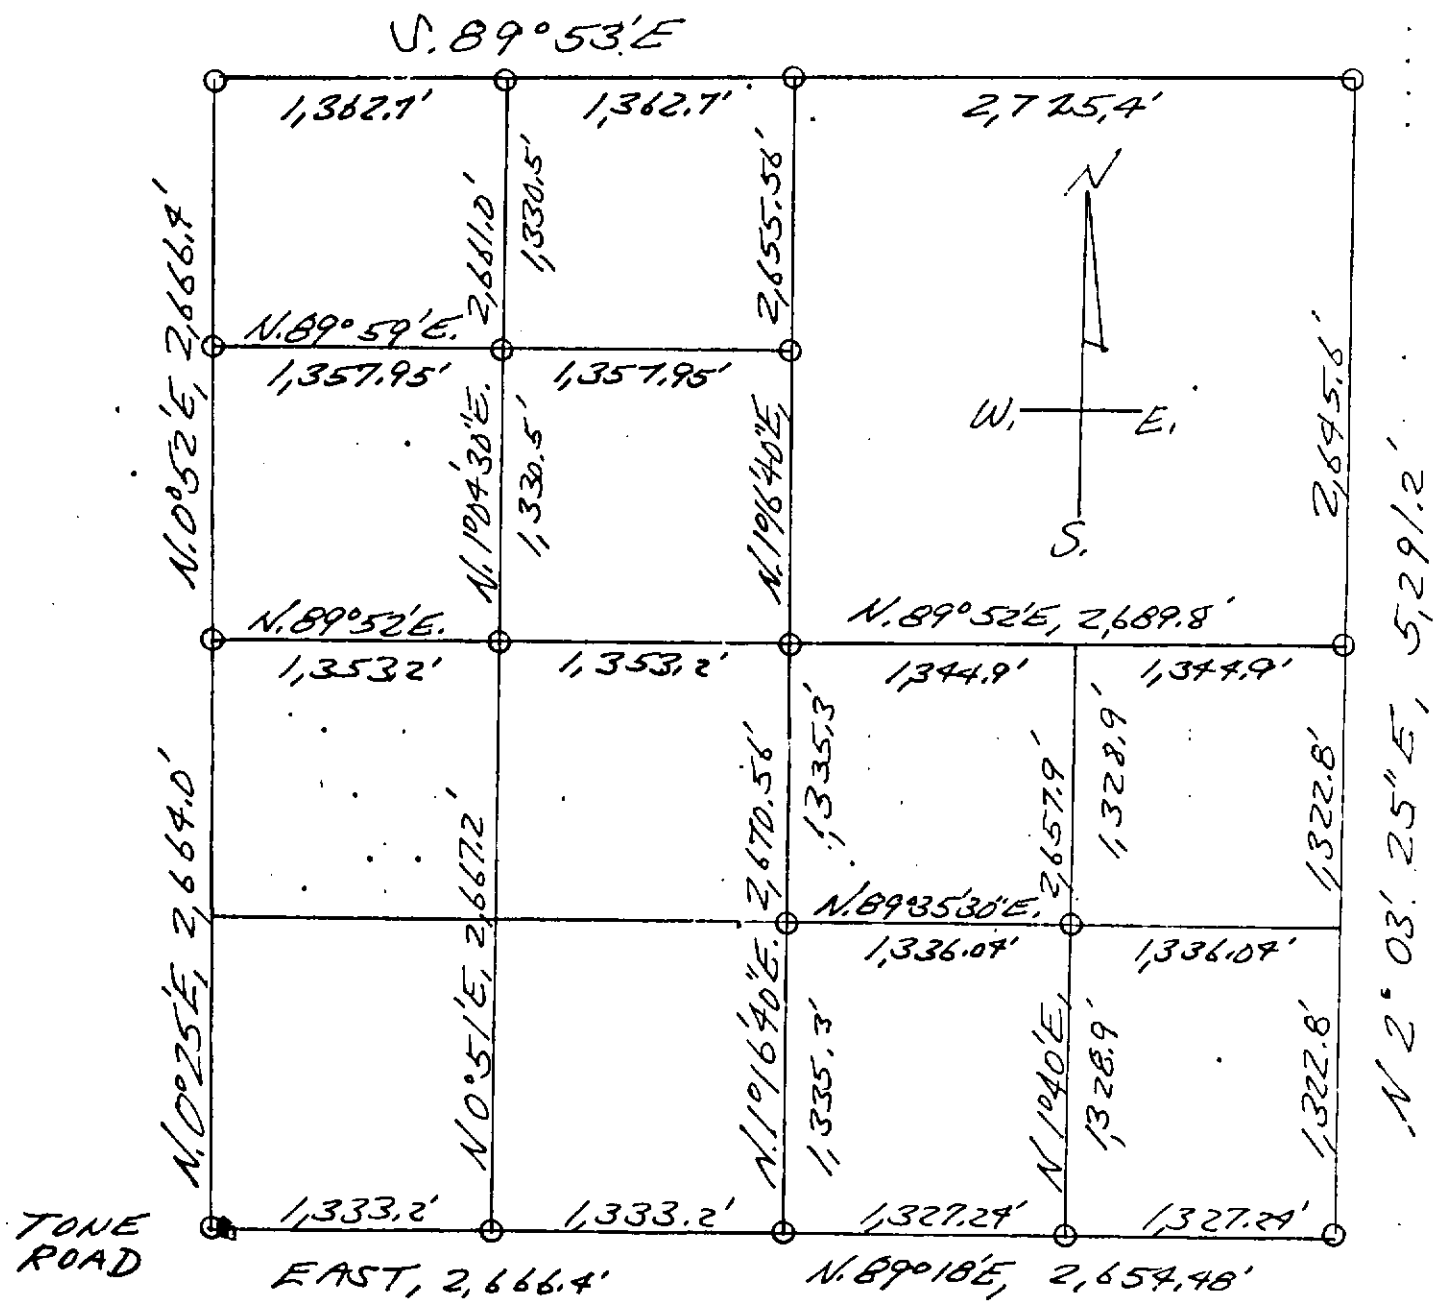

9-14-78
 Billy D. Buckler
 REG. LAND SURVEYOR