

LAND CORNER RECORDATION CERTIFICATE

FILING REQUIREMENT OF ACT 74, MICH. P.A.1970
Chippewa Co. Three Corners.

| FOR CORNERS OF--: | LOCATED IN--: | CORNER CODE NUMBER |
|--|--|----------------------|
| 1. PUBLIC LAND SURVEY _____ | T. <u>45</u> ^{N.} S. , R. <u>1</u> ^{E.} W. | L-6 |
| 2. PROPERTY CONTROLLING IN SECTION <u>14</u> | T. <u>45</u> ^{N.} S. , R. <u>1</u> ^{E.} W. | 6-Sec.14 5-Sec.14 |
| 3. MISCELLANEOUS PROPERTY IN SECTION _____ | T. _____ ^{N.} S. , R. _____ ^{E.} W. | |
| 4. LOT NO. _____, RECORDED PLAT _____ | | |
| 5. PRIVATE CLAIMS _____ | | |

REGISTER OF DEEDS STAMP AND FILING NUMBER

I, Billy D. Buckler do hereby certify that under requirements of P.A. 74, Michigan P.A. of 1970, the corner points mentioned in lines 1 and 2 above (identified with circles on index code diagram - over) were, in a field survey on 6-19 1974, established, re-established, monumented, re-monumented, recovered or restored as expressed below and in conformance with regulations and rules therefore as required in the current manual of survey instructions of the United States Department of the Interior, Bureau of Land Management or by a decree of a court of law. Furthermore, that the corner points mentioned in lines 3, 4 and 5 above were, in a field survey on _____ 19____, found, recovered, restored, established or re-established as expressed below and in conformance with the rules of the Michigan State Board of Registration for Land Surveyors or, by a Decree of a Court of law:

A. Description of original monument and accessories and/or subsequent restoration:

- 6-Sec.14 North-East 1/16 corner, Section 14.
- 5-Sec.14 North 1/16 corner, Section 14.
- L-6 Center Corner, Section 13.

B. Description of corner evidence found and/or method applied in restoring or re-establishing corner:

- 6-Sec.14 Corner placed at intersection of lines quartering the NORTH-EAST quarter section.
- 5-Sec.14 Corner placed midway bet $\frac{1}{4}$ Cor. to North and Center of Section to South.
- L-6 Corner placed at intersection of lines, connecting opposite quarter Corners.


C. Description of monument for corner and accessories established to perpetuate locating the position of the corner:

- 1" pipe with 4" aluminium cap placed at all corners.
- 6-Sec.14 Bearings: 8" Hard Maple, N69°E, 18.3' and 9" Hard Maple, N24°W, 34.5'
- 5-Sec.14 Bearings: 5" Cedar, S35°W, 31.5' and 5" Cedar, S8°E, 49.1'
- L-6 Bearings: 6" B. Spruce, N46°E, 12.0' and 10" W. Birch, N32°W, 6.4'

SIGNED BY Billy D. Buckler
Billy D. Buckler

DATE 10-30-74

SURVEYOR'S MICHIGAN REGISTRATION NO. 8887

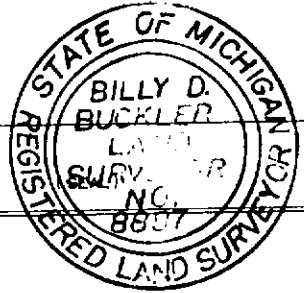

FOR STATE AND UNITED STATES AGENCIES:

SIGNED BY _____ DATE _____
CHIEF OF SURVEY PARTY

APPROVED AND SIGNED BY _____ DATE _____
MICHIGAN REGISTERED LAND SURVEYOR (SEAL)

SURVEYOR'S MICHIGAN REGISTRATION NO. _____