

LAND CORNER RECORDATION CERTIFICATE

FILING REQUIREMENT OF ACT 74, MICH. P.A.1970
Chippewa Co. 5 Corners.

FOR CORNERS OF--	LOCATED IN--	CORNER CODE NUMBER
1. PUBLIC LAND SURVEY _____	T. _____ N. S., R. _____ E. W.	1-Sec. 13
2. PROPERTY CONTROLLING IN SECTION <u>13</u>	T. <u>45</u> N. S., R. <u>1</u> E. W.	2-Sec. 13 8-Sec. 13 9-Sec. 13 12-Sec. 13
3. MISCELLANEOUS PROPERTY IN SECTION _____	T. _____ N. S., R. _____ E. W.	
4. LOT NO. _____, RECORDED PLAT _____		
5. PRIVATE CLAIMS _____		

REGISTER OF DEEDS STAMP AND FILING NUMBER

I, Billy D. Buckler do hereby certify that under requirements of P.A. 74, Michigan P.A. of 1970, the corner points mentioned in lines 1 and 2 above (identified with circles on index code diagram - over) were, in a field survey on 6-19 1974, established, re-established, monumented, re-monumented, recovered or restored as expressed below and in conformance with regulations and rules therefore as required in the current manual of survey instructions of the United States Department of the Interior, Bureau of Land Management or by a decree of a court of law. Furthermore, that the corner points mentioned in lines 3, 4 and 5 above were, in a field survey on _____ 19____, found, recovered, restored, established or re-established as expressed below and in conformance with the rules of the Michigan State Board of Registration for Land Surveyors or, by a Decree of a Court of law:

A. Description of original monument and accessories and/or subsequent restoration:

- 1-Sec.13 West 1/16 Corner, on North side Sec. 13.
- 2-Sec.13 East 1/16 Corner, on North side Sec. 13.
- 8-Sec.13 West 1/16 Corner, Section 13.
- 9-Sec.13 East 1/16 Corner, Section 13.
- 12-Sec.13 South 1/16 Corner, Section 13.

B. Description of corner evidence found and/or method applied in restoring or re-establishing corner:

- 1-Sec.13 Corner placed midway bet. Sec. Cor. to West and $\frac{1}{4}$ Cor. to East.
- 2-Sec.13 Corner placed midway bet. Sec. Cor. to East and $\frac{1}{4}$ Cor. to West.
- 8-Sec.13 Corner placed midway bet. $\frac{1}{4}$ Cor. to West and Center Cor. to East.
- 9-Sec.13 Corner placed midway bet. $\frac{1}{4}$ Cor. to East and Center Cor. to West.
- 12-Sec.13 Corner placed midway bet. $\frac{1}{4}$ Cor. to South and Center Cor. to North.


C. Description of monument for corner and accessories established to perpetuate locating the position of the corner:
1" pipe with 4" aluminium cap, placed at all corners.

- 1-Sec.13 Bearings: None available, corner sets in wet marsh.
- 2-Sec.13 Bearings: 10" W. Pine, West, 32.1' and 8" Cedar, N40°E, 28.7'
Corner lies in North edge of open marsh.
- 8-Sec.13 Bearings: 6" Soft Maple, S88°E, 35.7' and 8" Soft Maple, N11°E, 35.2'
- 9-Sec.13 Bearings: 12" W. Pine, S15°W, 15.7' and 16" W. Pine, N70°E, 10.3'
- 12-Sec.13 Bearings: 6" Soft Maple, N63°W, 20.9' and 6" Soft Maple, S73°W, 33.8'

SIGNED BY Billy D. Buckler

DATE 10-30-74

SURVEYOR'S MICHIGAN REGISTRATION NO. 8887

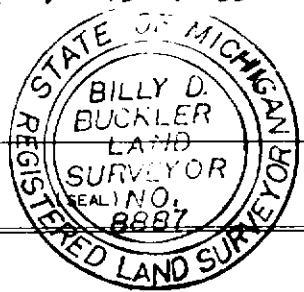

FOR STATE AND UNITED STATES AGENCIES:

SIGNED BY _____ DATE _____
CHIEF OF SURVEY PARTY

APPROVED AND SIGNED BY _____ DATE _____
MICHIGAN REGISTERED LAND SURVEYOR

(SEAL)

SURVEYOR'S MICHIGAN REGISTRATION NO. _____