

SURVEY & REMONUMENTATION

LAND CORNER RECORDATION CERTIFICATE

APR 07 1998

Filing Requirement of Act 74, Mich. P.A. 1970
Chippewa County Remonumentation Corner

For corners in

Chippewa County	SECTION	Located in:	Corner Code #
1. Public Land Survey	T45N R2W	(A-6) Same	
	T45N R3W	MP6 Corner	
	T R		
	T R		
2. Property Controlling in Section	S T R		
	S T R		
3. Miscellaneous Property in Sec.	S T R		
	S T R		
4. Lot No.		Recorded Plat	
5. Private Claims			

\$7.00 LAND CORNER
\$2.00 MSSR
6 Mar 1998 1:22:14 PM Receipt #6451
RECEIVED FOR RECORD
CHIPPEWA COUNTY - STATE OF MICHIGAN
SHARON H. KENNEDY, REGISTER OF DEEDS
BOOK 10 PAGE 157

Register of Deeds Stamp & File Number

I, Keith R. Waters, in a field survey on July 10, 1997, do hereby state that under requirements of P.A. 74, Michigan P.A. of 1970, the corner points mentioned in lines 1 and 2 above were in conformance with regulations and rules therefore as required in the current manual of survey instructions of the United States Department of the Interior, Bureau of Land Management or by a decree of a Court of Law and/or that the corner points mentioned in lines 3, 4 and 5 above were in conformance with the rules of the Michigan Board of Land Surveyors or by a Decree of a Court of Law; established, re-established, monumented, recovered, found as expressed below:

NOTE: Not more than 2 corners, all in the same town and range, may be recorded on this certificate.

A. Description of original monument and accessories and/or subsequent restoration:

A-6 1/4 Corner common to Sec. 18, T45N, R2W & Sec. 13, T45N, R3W

1840 - Original corner was established by Austin Burt, D.S.
Witnesses: Sugar 18, S76°W 53 links - Sugar 18, N55°W 22 links.

1982 - LCRC liber 5, page 223, William L. Karr, P.S. 27450. Found a 4"x4" wood post with a 12" spike set next to post. Replaced spike with a 1/2" iron. Witnesses: Centerline of north-south road, East 15.5' - 12" Maple, N37°E 61.61' - 8" Maple, S45°E 58.74' - 8" Maple, S13°W 36.46' - 12" Maple, N71°W 11.72'

B. Description of corner evidence found and/or method applied in restoring or reestablishing corner:



This corner is being perpetuated as part of the Chippewa County Remonumentation Program. Found a 1/2" iron and all four bearing trees as called for in above mentioned LCRC. This position checks very well with other corners south on the range line in both north-south and east-west directions. Accepted corner position as found.

C. Description of monument for corner and accessories established to perpetuate locating the position of the corner:

Found a 1/2" rebar at corner position, next to a rotted 4"x4" post, 15 feet west of a north-south dirt road.
Witnesses:

- 12" Maple, N37°E 61.61'
- 8" Maple, S45°E 58.74'
- 8" Maple, S13°W 36.46'
- 12" Maple, N71°W 11.72'

Note: Distances are to a nail in the side of the tree.
Bearings are compass bearings corrected for declination.

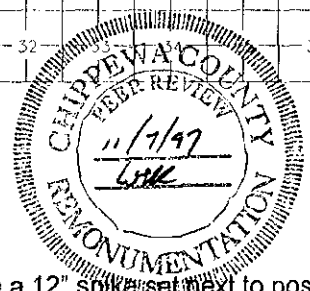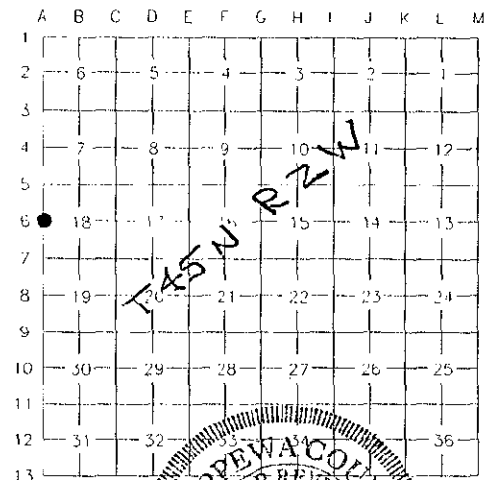

Signed by Keith R. Waters

Date 12-30-97

Surveyor's Michigan License No. 33142