

APR 07 1998

LAND CORNER RECORDATION CERTIFICATE
 Filing Requirement of Act 74, Mich. P.A. 1970
 Chippewa County Remonumentation Corner

SECTION

For corners in

| | | |
|------------------------------------|-------------|---------------|
| Chippewa County | Located in: | Corner Code # |
| 1. Public Land Survey | T45N R2W | A-11 Same |
| | T45N R3W | M-11 Corner |
| | T | R |
| | T | R |
| 2. Property Controlling in Section | S | T R |
| | S | T R |
| 3. Miscellaneous Property in Sec. | S | T R |
| | S | T R |
| 4. Lot No. , Recorded Plat | | |
| 5. Private Claims | | |

\$7.00 LAND CORNER
 \$2.00 NCSR
 6 Mar 1998 1:29:57 PM Receipt #6451
 RECEIVED FOR RECORD
 CHIPPEWA COUNTY - STATE OF MICHIGAN
 SHARON H. KENNEDY, REGISTER OF DEEDS

BOOK 10 PAGE 162
 Register of Deeds Stamp & File Number

I, Keith R. Waters, in a field survey on June 11, 1997, do hereby state that under requirements of P.A. 74, Michigan P.A. of 1970, the corner points mentioned in lines 1 and 2 above were in conformance with regulations and rules therefore as required in the current manual of survey instructions of the United States Department of the Interior, Bureau of Land Management or by a decree of a Court of Law and/or that the corner points mentioned in lines 3, 4 and 5 above were in conformance with the rules of the Michigan Board of Land Surveyors or by a Decree of a Court of Law; established, re-established, monumented, recovered, found as expressed below:

NOTE: Not more than 2 corners, all in the same town and range, may be recorded on this certificate.

A. Description of original monument and accessories and/or subsequent restoration:

A-11 Cor. common to Secs. 30&31, T45N,R2W & Secs. 25&36, T45N,R3W

1840 - Original corner was established by Austin Burt, D.S.
 Witnesses: Pine 16, N21°W 15 links - Birch 16, North 7 links.

1849 - Witnesses added by Harvey Mellen, D.S., during the subdivision of Town 45 North, Range 2 West:
 Tamarack 16, S70°E 36 links - Cedar 10, N65°E 29 links.

1924 - Chippewa County Surveyor Frederick H. Brown indicates an original government corner and pine bearing tree. Put in monument and gas pipe. He also shows a distance of 10565 feet to section E-11 two miles to the east. Distances are also shown east to fences and to the range of a school house.

B. Description of corner evidence found and/or method applied in restoring or reestablishing corner:


This corner is being perpetuated as part of the Chippewa County Remonumentation Program. Found a 1½" iron pipe at the intersection of 17 Mile Road and Postma Road. The distance east to Section corner E-11 is 10565.0 feet, which is the same as shown in above mentioned Brown notes. The distance east to the remains of the foundation of the old Holland School House also checks with said notes. Accepted corner location as found.

C. Description of monument for corner and accessories established to perpetuate locating the position of the corner:

Found a 1½" iron pipe at corner location. Corners falls in the gravel intersection of 17 Mile Road and Postma Road.
 Witnesses:

- 12" Willow, S32°E 47.25'
- Fence Post, N43°E 80.30'
- 9" Willow, N47°W 40.53'
- Power Pole (RU2-115-32), S45°W 39.56'

Note: Distances are to a nail/tag #22428 in the side of the witness object. Bearings are compass bearings corrected for declination.

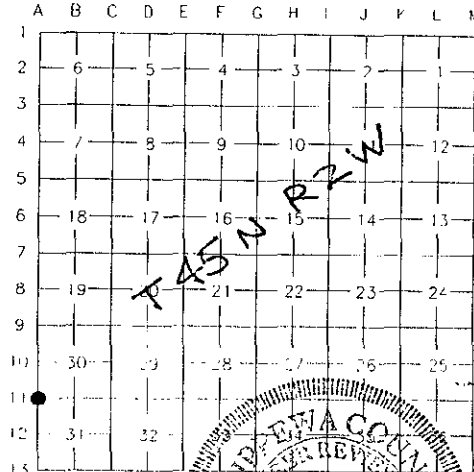

Signed by Keith R. Waters

Date 12-30-97

Surveyor's Michigan License No. 33142