

**SURVEY &  
REMONUMENTATION**

APR 07 1998

**LAND CORNER RECORDATION CERTIFICATE**  
Filing Requirement of Act 74, Mich. P.A. 1970  
Chippewa County Remonumentation Corner

For corners in **SECTION**

Chippewa County	Located in:	Corner Code #
1. Public Land Survey	T45N R2W	C-10
	T R	
	T R	
	T R	
2. Property Controlling in Section	S T R	
	S T R	
3. Miscellaneous Property in Sec.	S T R	
	S T R	
4. Lot No. , Recorded Plat		
5. Private Claims		

\$7.00 LAND CORNER  
\$2.00 MSSR  
6 Mar 1998 1:36:20 PM Receipt #6451  
RECEIVED FOR RECORD  
CHIPPEWA COUNTY - STATE OF MICHIGAN  
SHARON H. KENNEDY, REGISTER OF DEEDS

BOOK 10 PAGE 172

Register of Deeds Stamp & File Number

I, Keith R. Waters, in a field survey on April 11, 1997, do hereby state that under requirements of P.A. 74, Michigan P.A. of 1970, the corner points mentioned in lines 1 and 2 above were in conformance with regulations and rules therefore as required in the current manual of survey instructions of the United States Department of the Interior, Bureau of Land Management or by a decree of a Court of Law and /or that the corner points mentioned in lines 3, 4 and 5 above were in conformance with the rules of the Michigan Board of Land Surveyors or by a Decree of a Court of Law; established, re-established, monumented, recovered, found as expressed below:

NOTE: Not more than 2 corners. all in the same town and range, may be recorded on this certificate.

A. Description of original monument and accessories and/or subsequent restoration:

C-10 1/4 Corner common to Sections 29 & 30, Town 45 North, Range 2 West

1849 - Original corner (spruce post) was established by Harvey Mellen, D.S.

Witnesses: Spruce 8, N46°E 36 links  
White Pine 16, N19°W 16 links

1921 - County Surveyor Frederick H. Brown notes for Section 30 indicate a large stone set from an original bearing tree. The only other information shown is a note saying "8 rods long by computation" on the north 1/2 mile between Sections 29 and 30.

B. Description of corner evidence found and/or method applied in restoring or reestablishing corner:

This corner is being perpetuated as part of the Chippewa County Remonumentation Program. Found a 1/2" rebar in the approximate centerline of north-south asphalt road (Tilson Road), on the extension of a fence line to the west. Rebar is 2618.81 feet from the section corner to the north, 2617.66 feet from the section corner to the south, and is 10.2 feet east of a straight line between said section corners. Accepted corner as found.


C. Description of monument for corner and accessories established to perpetuate locating the position of the corner:

Found a 1/2" rebar at the corner location, which falls in the approximate centerline of Tilson Road, on the extension of a fence line to the west.  
Witnesses:

Power Pole (E46), S09°E 236.97'  
Power Pole (E45), S88°E 36.97'  
Power Pole (E44), N08°E 236.86'  
Power Pole (E4401), N09°W 234.22'

Note: Distances are to a nail/tag #33142 in the side of the pole.  
Bearings are compass bearings corrected for declination.

	A	B	C	D	E	F	G	H	I	J	K	L	M
1													
2	6		5		4		3		2		1		
3													
4	7		8		9		10		11		12		
5													
6	18		17		16		15		14		13		
7													
8	19		20		21		22		23		24		
9													
10	30		29		28		27		26		25		
11													
12	31		32		33		34		35		36		
13													

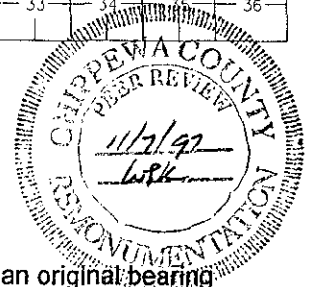

Signed by Keith R. Waters

Date 12-30-97

Surveyor's Michigan License No. 33142