

CHIPPEWA COUNTY REMONUMENTATION CORNER

MAR 27 1996

LAND CORNER RECORDATION CERTIFICATE
Filing Requirement of Act 74, Mich. P.A. 1970

For corners in

Chippewa
(County)

Located in:

Corner Code #

1. Public Land Survey

T 46NR 2W

E-13 Same

T 45NR 2W

E-1 Corner

T R

T R

2. Property Controlling
in Section

S T R

S T R

3. Miscellaneous
Property in Sec.

S T R

S T R

4. Lot No. _____, Recorded Plat _____

5. Private Claims _____

\$ 7.00 LAND CORNER

\$ 2.00 MSSR

29 FEB 96 9:30 A.M.

RECEIPT# 462

RECEIVED FOR RECORD

CHIPPEWA COUNTY - STATE OF MICHIGAN

SHARON H. KENNEDY, REGISTER OF DEEDS

Register of Deeds Stamp & File Number

I, Larry R. Rogers, in a field survey on Oct. 23, 1995 do hereby state that under requirements of P.A. 74, Michigan P.A. of 1970, the corner points mentioned in lines 1 and 2 above were in conformance with regulations and rules therefore as required in the current manual of survey instructions of the United States Department of the Interior, Bureau of Land Management or by a decree of a Court of Law and/or that the corner points mentioned in lines 3, 4 and 5 above were in conformance with the rules of the Michigan Board of Land Surveyors or by a Decree of a Court of Law; established, re-established, monumented, recovered, found as expressed below:

NOTE: Not more than 2 corners, all in the same town and range, may be recorded on this certificate.

	A	B	C	D	E	F	G	H	I	J	K	L	M
1													
2	6		5		4		3		2		1		
3													
4	7		8		9		10		11		12		
5													
6	18		17		16		15		14		13		
7													
8	19		20		21		22		23		24		
9													
10	30		29		28		27		26		25		
11													
12	31		32		33		34		35		36		
13													

A. Description of original monument and accessories and/or subsequent restoration:

(E-13) Southwest Corner of Section 33

1840: Austin Burt "marked a 24" Pine at corner of Sections 32 and 33". No witnesses were recorded.

1990: Gerald L. Wiggins, P.S. 23521. Corner recorded in Liber 7, Page 244 of the Chippewa County Corner Records as a "DNR Monument" set by single proportionate measurement from corners 1 mile to East and West with the following witnesses:

Fence Post	N62°E	25.3'	4" Elm	S62°E	69.1'
Fence Post	S80°E	21.8'	10" Birch	S35°W	41.4'


B. Description of corner evidence found and/or method applied in restoring or reestablishing corner:

(E-13) This corner is being perpetuated as part of the Chippewa County Remonumentation program. Found no evidence of original corner position. Found "DNR Monument". Recovered three DNR witnesses (Elm gone). Bearings and distances work well. Accepted monument as found and established one new witness.

C. Description of monument for corner and accessories established to perpetuate locating the position of the corner:

(E-13) Corner is a Michigan D.N.R. stamped aluminum cap on a 3/4" iron pipe next to a squared wood post.

Witnesses:	7" Spruce	N05°E	26.82'
	Fence Post	N59°E	25.29'
	Fence Post	S83°E	22.11'
	10" White Birch	S31°W	40.94'

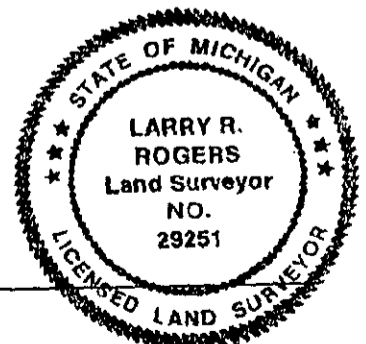

Signed by _____

Surveyor's Michigan License No. 29251

Date 27 DEC 1995

NOTE: Bearings are compass bearings corrected for declination. Distances are to a nail in side of witness objects unless noted.