

SURVEY & REMONUMENTATION

FILED 11/7/97
11/7/97

APR 07 1998

LAND CORNER RECORDATION CERTIFICATE
Filing Requirement of Act 74, Mich. P.A. 1970

Chippewa County Remonumentation Corner **47.00 LAND CORNER**

SECTION

For corners in

Chippewa County	Located in:	Corner Code #
1. Public Land Survey	T45N R2W	E-10
	T R	
	T R	
	T R	
2. Property Controlling in Section	S T R	
	S T R	
3. Miscellaneous Property in Sec.	S T R	
	S T R	
4. Lot No.	Recorded Plat	
5. Private Claims		

42.00 MSSR
6 Mar 1998 1:43:29 PM Receipt #6451
RECEIVED FOR RECORD
CHIPPWEA COUNTY - STATE OF MICHIGAN
SHARON H. KENNEDY, REGISTER OF DEEDS

BOOK 10 PAGE 180

Register of Deeds Stamp & File Number

	A	B	C	D	E	F	G	H	I	J	K	L	M
1													
2	6		5		4		3		2		1		
3													
4	7		8		9		10		11		12		
5													
6	18		17		16		15		14		13		
7													
8	19		20		21		22		23		24		
9													
10	30		29		28		27		26		25		
11													
12	31		32		33		34		35		36		
13													

I, Keith R. Waters, in a field survey on November 10, 1997, do hereby state that under requirements of P.A. 74, Michigan P.A. of 1970, the corner points mentioned in lines 1 and 2 above were in conformance with regulations and rules therefore as required in the current manual of survey instructions of the United States Department of the Interior, Bureau of Land Management or by a decree of a Court of Law and /or that the corner points mentioned in lines 3, 4 and 5 above were in conformance with the rules of the Michigan Board of Land Surveyors or by a Decree of a Court of Law; established, re-established, monumented, recovered, found as expressed below:


NOTE: Not more than 2 corners, all in the same town and range, may be recorded on this certificate.

A. Description of original monument and accessories and/or subsequent restoration:

E-10 1/4 Corner common to Sections 28 & 29, Town 45 North, Range 2 West

1849 - Original corner (birch post) was established by Harvey Mellen, D.S.
Witnesses: Spruce 7, N29°E 78 links - Spruce 6, N10°W 75 links

1908 - Chippewa County Surveyor Frederick H. Brown notes for Section 28 indicate this corner midway between section corners 2637.5 feet north and 2637.5 feet south.

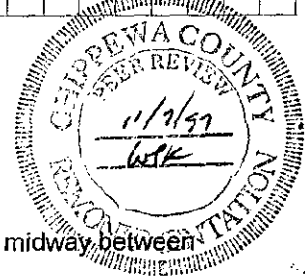

B. Description of corner evidence found and/or method applied in restoring or reestablishing corner:

This corner is being reestablished as part of the Chippewa County Remonumentation Program. Found no evidence of this corner or its accessories. The distance between section corners E-9 and E-11 is within 0.5 feet of that as shown in above mentioned County Surveyors notes. Reestablished corner by single proportionate measurement midway on line between said section corners north and south. This position fits with an old fence at the north 1/16 line of Section 29. Corner position falls approximately 4 feet south of a newer fence line to the east, which was probably measured in 2640 feet from the section corner to the south. Another older fence line to the west is approximately 12 feet north of this corner position. However, common ownership on both sides of the east-west 1/4 line in Section 29, and the meandering course of this fence, indicate that it was probably erected as a containment fence.

C. Description of monument for corner and accessories established to perpetuate locating the position of the corner:

Placed a 3/4" x 24" rebar with a plastic Chippewa County Remonumentation cap at the corner location, which falls in the approximate centerline of a north-south gravel road (Centerline Road).
Witnesses:

- Power Pole, N06°W 254.61'
- Power Pole, S52°W 104.52'
- Power Pole (RU2-121), S18°W 410.14'
- Fence Post, N54°E 43.12'

Note: Distances are to a nail/tag #33142 in the side of the witness object. Bearings are compass bearings corrected for declination.



Signed by Keith R. Waters

Date 12-30-97

Surveyor's Michigan License No. 33142

FORM APPROVED BY MICHIGAN STATE BOARD OF PROFESSIONAL SURVEYORS, JAN 28, 1971
REVISED MAY 14, 1975
REVISED JAN., 1983
REVISED OCT., 1995