

**SURVEY &
REMONUMENTATION**

PK: 11/13/97

APR 07 1998

LAND CORNER RECORDATION CERTIFICATE

Filing Requirement of Act 74, Mich. P.A. 1970

Chippewa County Remonumentation Corner

\$7.00 LAND CORNER

SECTION

For corners in

Chippewa County	Located in:	Corner Code #
1. Public Land Survey	T45N R2W	E-12
	T R	
	T R	
	T R	
2. Property Controlling in Section	S T R	
	S T R	
3. Miscellaneous Property in Sec.	S T R	
	S T R	
4. Lot No.	Recorded Plat	
5. Private Claims		

\$2.00 HSSR
6 Mar 1998 1:45:58 PM Receipt #6451
RECEIVED FOR RECORD
CHIPPEWA COUNTY - STATE OF MICHIGAN
SHARON H. KENNEDY, REGISTER OF DEEDS

BOOK 10 PAGE 182

Register of Deeds Stamp & File Number

A	B	C	D	E	F	G	H	I	J	K	L	M
1												
2	4	5	4	3	2							
3												
4	7	8	9	10	11	12						
5												
6	18	7	16	15	14	13						
7												
8	19	20	21	22	23	24						
9												
10	30	29	28	27	26	25						
11												
12	31	32	33	34	35	36						
13												

I, Keith R. Waters, in a field survey on November 11, 1997, do hereby state that under requirements of P.A. 74, Michigan P.A. of 1970, the corner points mentioned in lines 1 and 2 above were in conformance with regulations and rules therefore as required in the current manual of survey instructions of the United States Department of the Interior, Bureau of Land Management or by a decree of a Court of Law and/or that the corner points mentioned in lines 3, 4 and 5 above were in conformance with the rules of the Michigan Board of Land Surveyors or by a Decree of a Court of Law; established, re-established, monumented, recovered, found as expressed below:

NOTE: Not more than 2 corners, all in the same town and range, may be recorded on this certificate.


A. Description of original monument and accessories and/or subsequent restoration:

E-12 1/4 Corner common to Sections 32 & 33, Town 45 North, Range 2 West

1849 - Original corner (spruce post) was established by Harvey Mellen, D.S.

Witnesses: White Pine 24, N45°E 12 121 links - White Pine 24, S82°W 76 links

1908 - Chippewa County Surveyor Frederick H. Brown notes for Section 28 indicate a distance of 5275 feet on the west side of Section 33, with a distance of 2628 feet on the north 1/2 mile.

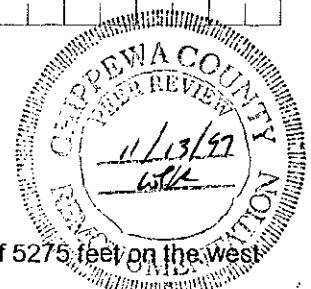

B. Description of corner evidence found and/or method applied in restoring or reestablishing corner:

This corner is being reestablished as part of the Chippewa County Remonumentation Program.

Found no evidence of the corner or its accessories. The distance between the section corner E-11 to the north and the standard corner E-13 on the township line to the south is 5276.18 feet, above mentioned County Surveyor notes showed 5275 feet. Reestablished corner on line between said section corners at the proportionate north-south position with said County Surveyor notes. This position works well with a fence at the north 1/16 line of Section 32. Corner falls 9.5 feet north of a fence line to the east and 6.7 feet north of a fence line to the west. Several hundred feet to the west of the road there is another fence line, which is north of said fence that is 6.7 feet south of the corner.

C. Description of monument for corner and accessories established to perpetuate locating the position of the corner:

Placed a 3/4" x 24" rebar with a plastic Chippewa County Remonumentation cap at the corner location, which falls approximately 2 feet west of the centerline of a north-south gravel road (Centerline Road).

Witnesses:

Power Pole (RU2-104), S12°W 338.78'

Power Pole (RU2-106), N08°W 320.66'

Corner Fence Post, S70°E 31.48'

Corner Fence Post, S77°W 27.05'

Note: Distances are to a nail/tag #33142 in the side of the witness object.

Bearings are compass bearings corrected for declination.



Signed by Keith R. Waters

Date 12-30-97

Surveyor's Michigan License No. 33142