

MAR 27 1996

COMMISSION

CHIPPEWA COUNTY REMONUMENTATION CORNER
LAND CORNER RECORDATION CERTIFICATE
Filing Requirement of Act 74, Mich. P.A. 1970

For corners in

<u>Chippewa</u> (County)	Located in:	Corner Code #
1. Public Land Survey	T 46NR 2W	F-13 Same
	T 45NR 2W	F-1 Corner
	T ___ R ___	_____
	T ___ R ___	_____
2. Property Controlling in Section	S ___ T ___ R ___	_____
	S ___ T ___ R ___	_____
3. Miscellaneous Property in Sec.	S ___ T ___ R ___	_____
	S ___ T ___ R ___	_____
4. Lot No. _____, Recorded Plat _____		
5. Private Claims _____		

\$ 7.00 LAND CORNER
 \$ 2.00 MSSR
 29 FEB 96 9:30 A.M. RECEIPT# 462
 RECEIVED FOR RECORD
 CHIPPEWA COUNTY - STATE OF MICHIGAN
 SHARON H. KENNEDY, REGISTER OF DEEDS

Register of Deeds Stamp & File Number

I, Larry R. Rogers, in a field survey on October 23, 19 95 do hereby state that under requirements of P.A. 74, Michigan P.A. of 1970, the corner points mentioned in lines 1 and 2 above were in conformance with regulations and rules therefore as required in the current manual of survey instructions of the United States Department of the Interior, Bureau of Land Management or by a decree of a Court of Law and /or that the corner points mentioned in lines 3, 4 and 5 above were in conformance with the rules of the Michigan Board of Land Surveyors or by a Decree of a Court of Law; established, re-established, monumented, recovered, found as expressed below:

NOTE: Not more than 2 corners, all in the same town and range, may be recorded on this certificate.

A	B	C	D	E	F	G	H	I	J	K	L	M
1												
2	6	5	4	3	2	1						
3												
4	7	8	9	10	11	12						
5												
6	18	17	16	15	14	13						
7												
8	19	20	21	22	23	24						
9												
10	30	29	28	27	26	25						
11												
12	31	32	33	34	35	36						
13												

A. Description of original monument and accessories and/or subsequent restoration:
 (F-13) South 1/4 Corner of Section 33, T46N, R2W.

1840: Austin Burt "set quarter Section post" with the following witnesses:
 14" Sugar N29E 9 links
 6" Maple N50W 42 links

B. Description of corner evidence found and/or method applied in restoring or reestablishing corner.


(F-13) This corner is being perpetuated as part of the Chippewa County Remonumentation Program.

Found no evidence of original corner position or any subsequent restoration. Reestablished corner position midway and online between the Southeast and Southwest corners of Section 33. Corner falls 46 feet South of the centerline of 12 Mile Road (gravel).

C. Description of monument for corner and accessories established to perpetuate locating the position of the corner:

(F-13) Corner is a 3/4"x24" iron with plastic "Chippewa County Remonumentation" cap, 46 feet South of the centerline of 12 Mile Road.

Witnesses:	4" Spruce	N66°E	203.88'
	Fence Post	N50°E	32.45'
	Fence Post	S89°E	407.31'
	3" Spruce	N86°W	257.13'
	7" Spruce	N80°W	264.25'
	East-West Fence	North	64.50'

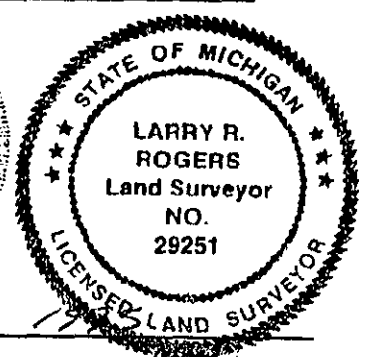

Signed by [Signature]
 Surveyor's Michigan License No. 29251

Date 25 DEC 1995

NOTE: All bearings are compass bearings corrected for declination. All distances are to a nail in side of witness objects unless otherwise noted.