

**SURVEY & REMONUMENTATION**

KIRK ROSE TWP  
11/2/97

**APR 07 1998**

**LAND CORNER RECORDATION CERTIFICATE**  
Filing Requirement of Act 74, Mich. P.A. 1970  
Chippewa County Remonumentation Corner

**SECTION**

For corners in

Chippewa County	Located in:	Corner Code #
1. Public Land Survey	T45N R2W	F-7
	T R	
	T R	
	T R	
2. Property Controlling in Section	S T R	
	S T R	
3. Miscellaneous Property in Sec.	S T R	
	S T R	
4. Lot No. , Recorded Plat		
5. Private Claims		

\$7.00 LAND CORNER  
\$2.00 MSSR  
6 Mar 1998 1:46:31 PM Receipt #6451  
RECEIVED FOR RECORD  
CHIPPewa COUNTY - STATE OF MICHIGAN  
SHARON H. KENNEDY, REGISTER OF DEEDS

BOOK **10** PAGE **183**

Register of Deeds Stamp & File Number

I, Keith R. Waters, in a field survey on November 11, 1997, do hereby state that under requirements of P.A. 74, Michigan P.A. of 1970, the corner points mentioned in lines 1 and 2 above were in conformance with regulations and rules therefore as required in the current manual of survey instructions of the United States Department of the Interior, Bureau of Land Management or by a decree of a Court of Law and /or that the corner points mentioned in lines 3, 4 and 5 above were in conformance with the rules of the Michigan Board of Land Surveyors or by a Decree of a Court of Law; established, re-established, monumented, recovered, found as expressed below:

NOTE: Not more than 2 corners, all in the same town and range, may be recorded on this certificate.

A. Description of original monument and accessories and/or subsequent restoration:

F-7 ¼ Corner common to Sections 16 & 21, Town 45 North, Range 2 West

1849 - Original corner (cedar post) was established by Harvey Mellen, D.S.  
Witnesses: Cedar 8, N61°E 8 links  
Tamarack 20, S52°W 8 links

1908, 1913 - Chippewa County Surveyor Frederick H. Brown notes for Sections 16 and 21 indicate that this corner was gone.

B. Description of corner evidence found and/or method applied in restoring or reestablishing corner:



This corner is being reestablished as part of the Chippewa County Remonumentation Program. Found no evidence of this corner or its accessories. Reestablished corner by single proportionate measurement midway on line between section corners east and west. Corner falls on the north edge of an east-west 2 track road, on the approximate extension of the remains of an old fence and small ditch line to the north and a large ditch line to the south. A newer fence line to the north is approximately 7 feet west of the corner.

C. Description of monument for corner and accessories established to perpetuate locating the position of the corner:

Placed a ¾" x 24" rebar with a plastic Chippewa County Remonumentation cap at the corner location, which falls on the north side of an east-west 2 track road, on the east side of a large wooden gate post.  
Witnesses:

5" Apple, S69°W 38.22'  
Corner Fence Post, S23°W 33.02'  
7" Balsam Poplar, N89°W 69.89'  
Southerly Gate Post, S14°E 11.16'

Note: Distances are to a nail/tag #33142 in the side of the witness object.  
Bearings are compass bearings corrected for declination.

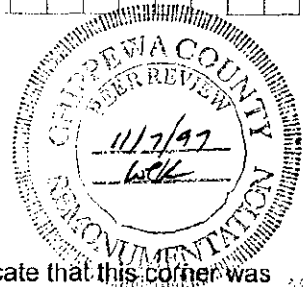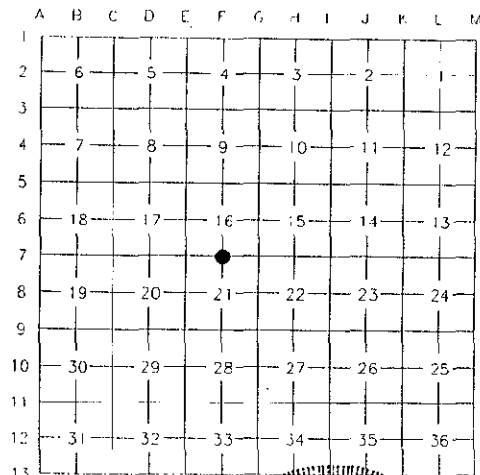

Signed by Keith R. Waters

Date 12-30-97

Surveyor's Michigan License No. 33142